

# Registration Statement

## OF CLAIMANT OF RIGHT TO APPROPRIATE GROUND WATER

TO THE STATE ENGINEER OF OREGON:

I, Robert W. Bennett

of Route 1, Box 45 Springfield County of Lane

(Mailing address)

State of Oregon, do hereby make application for a certificate of registration as evidence of a right to appropriate ground water.

1. Source from which water is withdrawn is Dug Well

(Flowing well, pump well, infiltration trench, or tunnel)

2. Location is: 3 Miles N.E. of Springfield Main St.

(Approximate distance and direction from nearest city or town)

and is more particularly described as follows:

(a) S 24 degrees east 2800' from NW corner of Sec. 19.

(Give distance and bearing to corner of section or other legal subdivision)

being within S W 1/2 N W 1/2 of Sec. 19, Twp. 17 S, Rge. 2 W

(Smallest legal subdivision)

(N. or S.)

(E. or W.)

or (b) within limits of recorded platted property, town or city:

in Lot \_\_\_\_\_, Block \_\_\_\_\_ of \_\_\_\_\_

(Name of plat or addition)

(If within city or town, give name)

County of Lane

3. Construction Work was begun on 1943; was completed on 1943

(Date)

(Date)

and the ground water claimed was first used for the purposes set out below on 1943

(Date)

since which time the water has been used Intermittently

(Continuously or Intermittently)

from May to Sept.

(Date)

(Date)

4. Quantity of water claimed and used is 200 gallons per minute; 10 acre

feet per year.

5. Purpose or Purposes for which water is used

Irrigation

(Domestic, irrigation, municipal, manufacturing, industrial, etc.)

6. Description of Well: Depth 20 feet. Type Dug

(Dug or drilled)

diameter 30 inches. Elevation of ground at well site 465 feet, mean sea level.

(As near as known)

Depth to water table 6' Spring 10 ft. fall

7. Capacity of Well: Not known g.p.m. with \_\_\_\_\_ feet drawdown.

200 g.p.m. with 6 inches feet drawdown.

Date of test From observation during regular use during irrigation.

If Flowing Well: Measured discharge \_\_\_\_\_ g.p.m. on \_\_\_\_\_

(Date)

Shut-in pressure at ground surface \_\_\_\_\_ lbs. per sq. in. on \_\_\_\_\_

(Date)

Water is controlled by \_\_\_\_\_

(Cap, valve, etc.)

8. Casing: (Give diameter, commercial specifications and depth below ground surface of each casing size.)

30" I.D.

inch diameter cement pipe from 0 to 20 feet  
 inch diameter from to feet  
 inch diameter from to feet  
 inch diameter from to feet

Describe and show depth of shoe, plug, adapter, liner or other details:

9. Perforated Casings or Screens:

(Number per foot and size of perforations, or describe screen) from to  
 from to  
 from to  
 from to

10. Log of Well: (Describe each stratum or formation clearly, indicate if water bearing, and give thickness and depth as indicated.)

MATERIAL	Thickness (Feet)	Depth to Bottom (Feet)
Uncosolidated $\beta$ True log not known		

If log of well is not available, give name and address of driller. ....

Driller's name not known .....

11. Infiltration Trench: Covered or open .....

Dimensions: Length ..... ft. Minimum depth ..... ft. Maximum depth ..... ft.

Bottom width ..... ft. Discharge ..... g.p.m. Date of test .....

12. Tunnel: Type of lining .....

Dimensions: .....  
(Length, course, and cross sectional size)

Position of water bearing stratum with reference to portal of tunnel .....

Log of tunnel: (Preceding table for log of well may be used, if desired. Give footage from portal and character of materials, as pertinent.)

13. Pumping Equipment:

(a) Pump Pacific Pump centrifugal 1 1/2" Capacity 225 g.p.m.  
(Make, type and size)


(b) Motor motor 5 HP  
(Type and horsepower)

14. Location of area irrigated or to be irrigated, or place of use if for purposes other than irrigation.

Township North or South	Range E. or W. of Willamette Meridian	Section	Forty-acre Tract	Number Acres To Be Irrigated	Date of Reclamation
I7 S	2 W	I9	NE Nw	I	1943
I7 S	2 W	I9	SE NW	5	"
I7 S	2 W	I9	SW NW	6	"
I7 S	2 W	I9	NW SW	I	"
				<u>13<sup>0</sup> Ac</u>	"

15. If the ground water supply is supplemental to an existing water supply, identification of any application for a permit, permit, certificate or adjudicated right to appropriate water made or held by the registrant.

Township 17S Range 2W, W.M.  
North

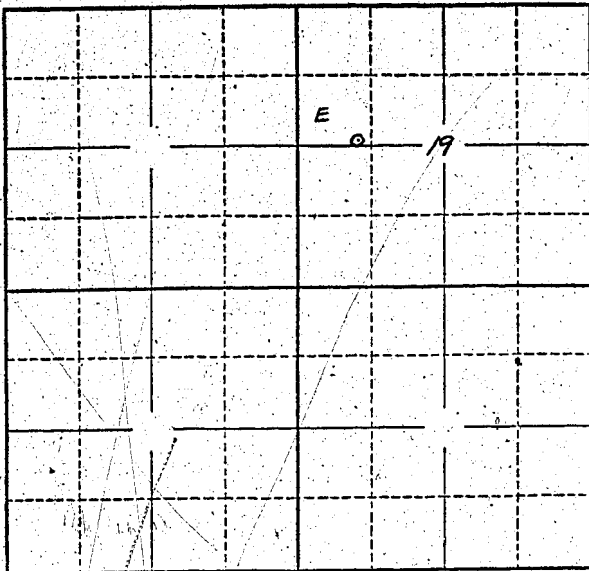

Locate well and acreage of irrigated land on plat.  
Scale: 2" = 1 Mile

STATE OF OREGON

County of Jane } ss.

I, Robert W. Bennett, being first duly sworn, do hereby certify that I have read the foregoing Registration Statement and that all of the items therein contained are true to the best of my knowledge and belief.

Robert W. Bennett  
(Signature of Registrant)

Subscribed and sworn to before me this 9<sup>th</sup> day of April, 1958

My commission expires Jan 18, 1962 Eidan W. Warden  
(Notary Public)

(SEAL)

**CERTIFICATE OF REGISTRATION**

STATE OF OREGON

County of Marion } ss.

This is to certify that the foregoing Registration Statement was received in the office of the State Engineer on the 10<sup>th</sup> day of April, 1958, at 8:00 o'clock A. M. and has been duly recorded in said office in Book No. 7 of Registration Statements on page GR-1346

Witness my hand this 20<sup>th</sup> day of October, 1958

Lewis A. Stanley  
(State Engineer)

By \_\_\_\_\_ (Deputy)

GR - 1346