

Registration Statement

OF CLAIMANT OF RIGHT TO APPROPRIATE GROUND WATER

(Under Chapter 703, Oregon Laws 1955.)

TO THE STATE ENGINEER OF OREGON:

I, GUST TANZEN
of RAUTEL, DAYTON, OREGON County of Polk and Yamhill

State of OREGON, do hereby make application for a certificate of registration as evidence of a right to appropriate ground water.

1. Source from which water is withdrawn is PUMP WELL
(Flowing well, pump well, infiltration trench, or tunnel)

2. Location is: 2 MILES SOUTH OF HOBENELL NEAR CO. LINE
(Approximate distance and direction from nearest city or town)

and is more particularly described as follows:

(a) 110 feet north and 280 feet west from SE 1/4 corner of section 6.
330 ± S at N Prop. Line 200 ± W of E Prop. Line
(Give distance and bearing to corner of section or other legal subdivision)

being within NE 1/4 of SE 1/4 of Sec. 6, Twp. 6S, Rge. 3W
(Smallest legal subdivision) (N. or S.) (E. or W.)

or (b) within limits of recorded platted property, town or city: Unapplicable

in Lot _____, Block _____ of _____
(Name of plat or addition)

County of _____
(If within city or town, give name)

3. Construction Work was begun on Oct 1952; was completed on Nov. 2, 1952
(Date) (Date)

and the ground water claimed was first used for the purposes set out below on May 1, 1953
(Date)

since which time the water has been used Continuously
(Continuously or Intermittently)

from May 1, 1953 to Nov. 1955
(Date) (Date)

4. Quantity of water claimed and used is 110 gallons per minute; _____ acre feet per year.

5. Purpose or Purposes for which water is used Irrigation & Domestic
(Domestic, irrigation, municipal, manufacturing, industrial, etc.)

6. Description of Well: Depth 142 feet. Type DRILLED
(Dug or drilled)

diameter 10 inches. Elevation of ground at well site 180' feet, mean sea level.
(As near as known)

Depth to water table FE feet.
Flowing well.

7. Capacity of Well: 80 g.p.m. with 115 feet drawdown. (Tested when drilled) 11/2/52

110 g.p.m. with 135 feet drawdown. (Err. pumps in early spring each year)

Date of test 11-2-52

If Flowing Well: Measured discharge 3 g.p.m. on 11-2-52
(Date)

Shut-in pressure at ground surface 5 lbs. per sq. in. on Feb. 1953
(Date)

Water is controlled by well seal & machine pump with valve
(Cap, valve, etc.)

8. Casing: (Give diameter, commercial specifications and depth below ground surface of each casing size.)

10.3 inch diameter from *Surface* to *122* feet
 inch diameter from to feet
 inch diameter from to feet
 inch diameter from to feet

Describe and show depth of shoe, plug, adapter, liner or other details: *None*

9. Perforated Casings or Screens:

None from to
 (Number per foot and size of perforations, or describe screen)
 from to
 from to
 from to

10. Log of Well: (Describe each stratum or formation clearly, indicate if water bearing, and give thickness and depth as indicated.)

MATERIAL	Thickness (Feet)	Depth to Bottom (Feet)
<i>Surface Soil</i>	<i>3</i>	<i>3</i>
<i>Clay</i>	<i>24</i>	<i>27</i>
<i>Clay with seepy water</i>	<i>1</i>	<i>28</i>
<i>Clay</i>	<i>31</i>	<i>59</i>
<i>Clay carrying water</i>	<i>1</i>	<i>60</i>
<i>Clay</i>	<i>46</i>	<i>106</i>
<i>Black Rock</i>	<i>1</i>	<i>107</i>
<i>Red Clay</i>	<i>2</i>	<i>109</i>
<i>Grey Shale</i>	<i>13</i>	<i>122</i>
<i>Broken rock & shale carrying water</i>	<i>13</i>	<i>135</i>
<i>Hard shale with Black rock streaks</i>	<i>7</i>	<i>142</i>

If log of well is not available, give name and address of driller J.T. MILLER

Box 198, Aurora, Oregon

11. Infiltration Trench: Covered or open unapp.

Dimensions: Length _____ ft. Minimum depth _____ ft. Maximum depth _____ ft.

Bottom width _____ ft. Discharge _____ g.p.m. Date of test _____

12. Tunnel: Type of lining Unapplicable

Dimensions: _____ (Length, course, and cross sectional size)

Position of water bearing stratum with reference to portal of tunnel _____

Log of tunnel: (Preceding table for log of well may be used, if desired. Give footage from portal and character of materials, as pertinent.)

13. Pumping Equipment: 6" Bowls Overall setting 135'

(a) Pump Fairbanks Morse Turbine 3" column Capacity 110 g.p.m.
(Make, type and size)


(b) Motor 7 1/2 H.P. 3 phase, 220 V. Fairbanks Morse 3450 RPM
(Type and horsepower)

14. Location of area irrigated or to be irrigated, or place of use if for purposes other than irrigation.

Township North or South	Range E. or W. of Willamette Meridian	Section	Forty-acre Tract	Number Acres To Be Irrigated	Date of Reclamation
T6S	3W	6	SE 1/4 of SE 1/4	28	May 1, 1953
T6S	3W	6	NE 1/4 of SE 1/4	2	"
				<u>30</u>	

15. If the ground water supply is supplemental to an existing water supply, identification of any application for a permit, permit, certificate or adjudicated right to appropriate water made or held by the registrant.

Township T6S Range R3W, W.M.
 North

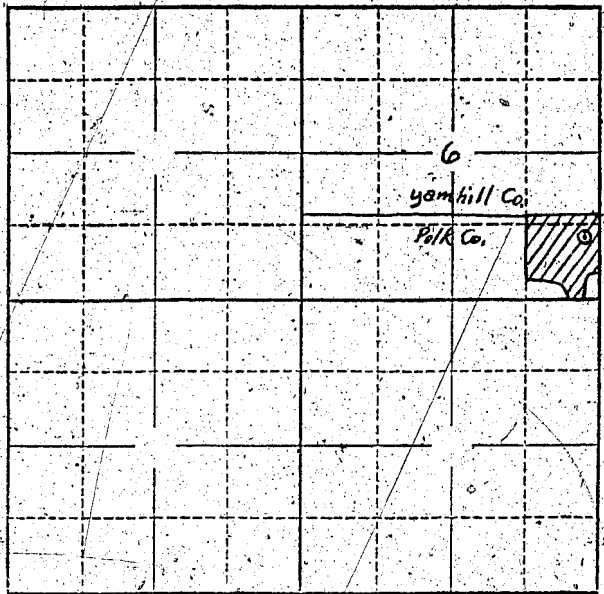

Locate well and acreage of irrigated land on plat.
 Scale: 2" = 1 Mile

STATE OF OREGON
 County of _____

I, Gust Janzen, being first duly sworn, do hereby certify that I have read the foregoing Registration Statement and that all of the items therein contained are true to the best of my knowledge and belief.

Gust Janzen
 (Signature of Registrant)

Subscribed and sworn to before me this 6th day of March, 1956

My commission expires _____
 (Notary Public)

(SEAL)

CERTIFICATE OF REGISTRATION

STATE OF OREGON
 County of Marion

This is to certify that the foregoing Registration Statement was received in the office of the State Engineer on the 6th day of March, 1956, at 1:30 o'clock, P.M. and has been duly recorded in said office in Book No. 1 of Registration Statements on page GR-129C.

Witness my hand this 12th day of April, 1956

Leuris A. Stanley
 (State Engineer)

By _____
 (Deputy)