

# Registration Statement

## OF CLAIMANT OF RIGHT TO APPROPRIATE GROUND WATER

TO THE STATE ENGINEER OF OREGON:

I, M. A. Steutenberg,  
of 1102 Redwood St. Salem, Ore. County of Polk  
(Mailing address)

State of Oregon do hereby make application for a certificate of registration as evidence of a right to appropriate ground water.

- 1. Source from which water is withdrawn is Pump Well  
(Of dug well, open well, infiltration trench, or tunnel)
- 2. Location is: 1/4 mile West of West Salem, Polk County Ore.  
(Approximate distance and direction from nearest city or town)

and is more particularly described as follows:

(a) 1370 feet South & 200 feet West from N 1/4 corner Sect. 16  
(Give distance and bearing to corner of section or other legal subdivision)  
being within SE 1/4 of NW 1/4 of Sec. 16, Twp. 7S, Rge. R3W  
(Smallest legal subdivision) (N. or S.) (E. or W.)

or (b) within limits of recorded platted property, town or city:

in Lot 1-A, Block 3 of Westridge Addition Annex #1  
(Name of plat or addition)  
County of Polk  
(If within city or town, give name)

- 3. Construction Work was begun on 3-12-54; was completed on 4-20-54  
(Date) (Date)

and the ground water claimed was first used for the purposes set out below on 7-1-55  
(Date)

since which time the water has been used Continuously  
(Continuously or intermittently)

from 7-1-55 to 4-9-58  
(Date) (Date)

- 4. Quantity of water claimed and used is 250 gallons per minute; \_\_\_\_\_ acre feet per year.

- 5. Purpose or Purposes for which water is used Group Domestic  
(Domestic, irrigation, municipal, manufacturing, industrial, etc.)

6. Description of Well: Depth 305' feet, Type Drilled  
(Dug or drilled)  
diameter 8" inches. Elevation of ground at well site 197' feet, mean sea level  
(As near as known)  
Depth to water table 50' feet.

- 7. Capacity of Well 250' g.p.m. with \_\_\_\_\_ feet drawdown.  
\_\_\_\_\_ g.p.m. with \_\_\_\_\_ feet drawdown.

Date of test 4-15-54

If Flowing Well: Measured discharge \_\_\_\_\_ g.p.m. on \_\_\_\_\_  
(Date)

Shut-in pressure at ground surface \_\_\_\_\_ lbs. per sq. in. on \_\_\_\_\_  
(Date)

Water is controlled by \_\_\_\_\_  
(Cap, valve, etc.)

8. Casing: (Give diameter, commercial specifications and depth below ground surface of each casing size.)

8" inch diameter *Steel Casing* from 0 to 34' feet  
 inch diameter from to feet  
 inch diameter from to feet  
 inch diameter from to feet

Describe and show depth of shoe, plug, adapter, liner or other details:

9. Perforated Casings or Screens:

*None* from to  
(Number per foot and size of perforations, or describe screen)  
 from to  
 from to  
 from to

10. Log of Well: (Describe each stratum or formation clearly, indicate if water bearing, and give thickness and depth as indicated.)

MATERIAL	Thickness (Feet)	Depth to Bottom (Feet)
<i>Sail and Clay</i>	<i>0</i>	<i>22</i>
<i>Weathered andesite</i>	<i>22</i>	<i>29</i>
<i>Fresh andesite</i>	<i>29</i>	<i>140</i>
<i>Shale Black</i>	<i>140</i>	<i>170</i>
<i>Basalt Fresh</i>	<i>170</i>	<i>305</i>

If log of well is not available, give name and address of driller Harry A. Robinson.

11. Infiltration Trench: Covered or open .....

Dimensions: Length ..... ft. Minimum depth ..... ft. Maximum depth ..... ft.

Bottom width ..... ft. Discharge ..... g.p.m. Date of test .....

12. Tunnel: Type of lining .....

Dimensions: .....  
(Length, course, and cross sectional size)

Position of water bearing stratum with reference to portal of tunnel .....

Log of tunnel: (Preceding table for log of well may be used, if desired. Give footage from portal and character of materials, as pertinent.)

13. Pumping Equipment:

(a) Pump Burbely Turbine Capacity 250 g.p.m.  
(Make, type and size)


(b) Motor 15 horse Electric  
(Type and horsepower)

14. Location of area irrigated or to be irrigated, or place of use if for purposes other than irrigation.

Township North or South	Range E. or W. of Willamette Meridian	Section	Forty-acre Tract	Number Acres To Be Irrigated	Date of Reclamation
T-7-S	R-3-W.	16	N.W. 1/4 of N.W. 1/4	Municipal	7-1-55
"	"	"	N.E. 1/4 of N.W. 1/4	"	"
"	"	"	N.W. 1/4 of N.E. 1/4	"	"
"	"	"	S.W. 1/4 of N.W. 1/4	"	"
"	"	"	S.E. 1/4 of N.W. 1/4	"	"
"	"	"	S.W. 1/4 of N.E. 1/4	"	"

15. If the ground water supply is supplemental to an existing water supply, identification of any application for a permit, permit, certificate or adjudicated right to appropriate water made or held by the registrant.

Township 75 Range 3W W.M.  
North

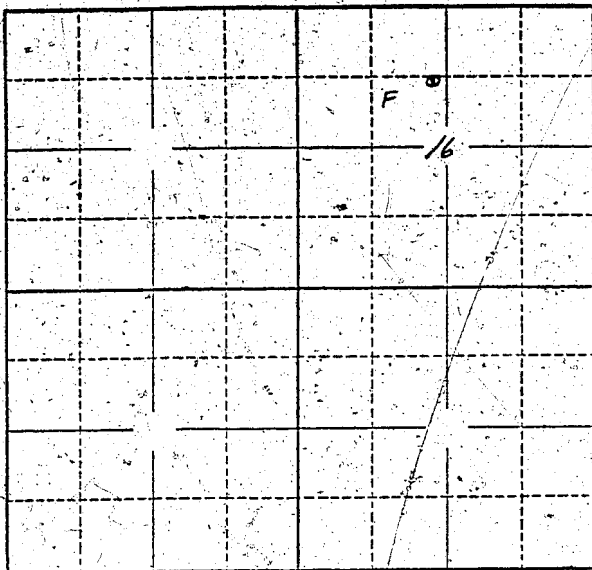

Locate well and acreage of irrigated land on plat.  
Scale: 2" = 1 Mile

STATE OF OREGON

County of Marion

ss.

I, \_\_\_\_\_, being first duly sworn, do hereby certify that I have read the foregoing Registration Statement and that all of the items therein contained are true to the best of my knowledge and belief.

M. A. Stoutenberg  
(Signature of Registrant)

Subscribed and sworn to before me this 10th day of April, 1958

My commission expires 12th June 1961

Wm. S. Bartholomew  
(Notary Public)

(SEAL)

**CERTIFICATE OF REGISTRATION**

STATE OF OREGON

County of Marion

ss.

This is to certify that the foregoing Registration Statement was received in the office of the State Engineer on the 10th day of April, 1958, at 11:20 o'clock A. M. and has been duly recorded in said office in Book No. 7 of Registration Statements on page GR-1318

Witness my hand this 20th day of October, 1958

Laura A. Stanley  
(State Engineer)

By \_\_\_\_\_ (Deputy)