

RECEIVED
APR 10 1958
STATE ENGINEER
SALEM, OREG.

Registration No. GR. 1392

Certificate No. GR. 1319

Registration Statement

OF CLAIMANT OF RIGHT TO APPROPRIATE GROUND WATER

TO THE STATE ENGINEER OF OREGON:

I, Vera Johnson Folkes
of Route 4, Kalispell County of Flathead
(Mailing address)

State of Montana, do hereby make application for a certificate of registration as evidence of a right to appropriate ground water.

- Source from which water is withdrawn is pump well
(Flowing well, pump well, infiltration trench, or tunnel)
- Location is: 3 Miles North east Milton Freeporter
(Approximate distance and direction from nearest city or town)

and is more particularly described as follows:

(a) 1321 ft. west of quarter section stone of N.E. quarter of Sec. 25
and thence 15 ft. North (Give distance and bearing to corner of section or other legal subdivision)
being within N.E. 1/4 N.E. 1/4 of Sec. 25, Twp. 6 N, Rge. 35 E
(Smallest legal subdivision) (N. or S.) (E. or W.)

or (b) within limits of recorded platted property, town or city: _____

in Lot _____, Block _____ of _____
(Name of plat or addition)

County of _____
(If within city or town, give name)

3. Construction Work was begun on Prior to 1917; was completed on Prior to 1917
(Date) (Date)

and the ground water claimed was first used for the purposes set out below on Prior to 1917
(Date)

since which time the water has been used CONTINUOUSLY
(Continuously or Intermittently)

from Prior to 1917 to 1954
(Date) (Date)

4. Quantity of water claimed and used is 300 gallons per minute; 102 acre feet per year.

5. Purpose or Purposes for which water is used irrigation

(Domestic, irrigation, municipal, manufacturing, industrial, etc.)

6. Description of Well: Depth 175 feet. Type Dug and Drilled
(Dug or drilled)

diameter Drilled 8 inches. Elevation of ground at well site 850 feet, mean sea level.
(As near as known)

Depth to water table _____ feet.

7. Capacity of Well: 300 g.p.m. with 18 feet drawdown.

_____ g.p.m. with _____ feet drawdown.

Date of test _____

If Flowing Well: Measured discharge _____ g.p.m. on _____
(Date)

Shut-in pressure at ground surface _____ lbs. per sq. in. on _____
(Date)

Water is controlled by _____
(Cap, valve, etc.)

8. Casing: (Give diameter, commercial specifications and depth below ground surface of each casing size.)

4.8 inch diameter *Concrete Tile* from to feet
 10 inch diameter *Steel* from to feet
 inch diameter from to feet
 inch diameter from to feet

Describe and show depth of shoe, plug, adapter, liner or other details:

.....

.....

9. Perforated Casings or Screens:

(Number per foot and size of perforations, or describe screen) from to

..... from to

..... from to

..... from to

10. Log of Well: (Describe each stratum or formation clearly, indicate if water bearing, and give thickness and depth as indicated.)

MATERIAL	Thickness (Feet)	Depth to Bottom (Feet)
<i>Top Soil</i>	<i>20</i>	<i>20</i>
<i>Cement Gravel</i>	<i>155</i>	<i>175</i>

If log of well is not available, give name and address of driller. Mr. Overturff
(deceased)

11. Infiltration Trench: Covered or open _____
 Dimensions: Length _____ ft. Minimum depth _____ ft. Maximum depth _____ ft.
 Bottom width _____ ft. Discharge _____ g.p.m. Date of test _____

12. Tunnel: Type of lining _____
 Dimensions: _____
(Length, course, and cross sectional size)
 Position of water bearing stratum with reference to portal of tunnel _____

Log of tunnel: (Preceding table for log of well may be used, if desired. Give footage, from portal and character of materials, as pertinent.)

13. Pumping Equipment:
 (a) Pump Fairbanks Morse Capacity 300 g.p.m.
(Make, type and size)
 (b) Motor 70 horse
(Type and horsepower)


14. Location of area irrigated or to be irrigated, or place of use if for purposes other than irrigation.

Township North or South	Range E. or W. of Willamette Meridian	Section	Four-acre Tract	Number Acres To Be Irrigated	Date of Reclamation
6N	35E	25	NE 1/4 + NE 1/4	25.5	Prior to 1917

15. If the ground water supply is supplemental to an existing water supply, identification of any application for a permit, permit, certificate or adjudicated right to appropriate water made or held by the registrant.
No other source of water for
irrigation

Township 6 N Range 35 E, W.M.

North

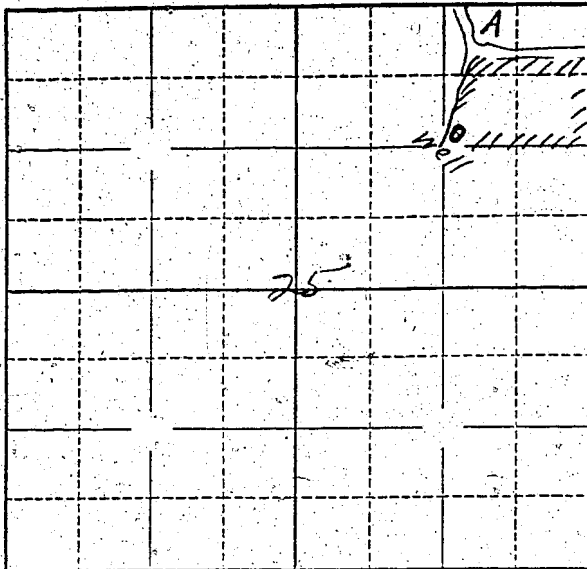

Locate well and acreage of irrigated land on plat.

Scale: ~~2~~ - 1 Mile

STATE OF ~~OREGON~~ MONTANA

County of Flathead

} ss.

I, Vera Johnson Folkles, being first duly sworn, do hereby certify that I have read the foregoing Registration Statement and that all of the items therein contained are true to the best of my knowledge and belief.

Vera Johnson Folkles
(Signature of Registrant)

Subscribed and sworn to before me this 7th day of April, 1958.

My commission expires Jan. 2, 1959

Charles Oldate
(Notary Public)

(SEAL)

CERTIFICATE OF REGISTRATION

STATE OF OREGON

County of Marion

} ss.

This is to certify that the foregoing Registration Statement was received in the office of the State Engineer on the 10th day of April, 1958, at 1:00 o'clock P. M. and has been duly recorded in said office in Book No. 7 of Registration Statements on page GR-1319

Witness my hand this 20th day of October, 1958.

Lewis A. Stanley
(State Engineer)

By _____
(Deputy)

GR - 1319