

# Registration Statement

## OF CLAIMANT OF RIGHT TO APPROPRIATE GROUND WATER

TO THE STATE ENGINEER OF OREGON:

I, Arthur A. Cook  
of P.O. Box 23A Indes County of Polk  
(Mailing address)

State of Ore, do hereby make application for a certificate of registration as evidence of a right to appropriate ground water.

1. Source from which water is withdrawn is Pumpwell #1  
(Flowing well, pump well, infiltration trench, or tunnel)

2. Location is: 6 1/2 mi. South & East of Indes  
(Approximate distance and direction from nearest city or town)

and is more particularly described as follows:

(a) 9320 ft. E. & 630 ft. S. of NE cor. of D.L.C. of A.V. McCarthy  
(Give distance and bearing to corner of section or other legal subdivision)  
being within SE 1/4 of NE 1/4 of Sec. 14, Twp. 9-5, Rge. 4-W  
(Smallest legal subdivision) (N. or S.) (E. or W.)

or (b) within limits of recorded platted property, town or city:

in Lot 0, Block \_\_\_\_\_ of \_\_\_\_\_  
(Name of plat or addition)  
County of \_\_\_\_\_  
(If within city or town, give name)

3. Construction Work was begun on May 1947; was completed on May 1947  
(Date) (Date)

and the ground water claimed was first used for the purposes set out below on June 1947  
(Date)

since which time the water has been used intermittently during season  
(Continuously or intermittently)

from May 1947 to Oct 1957  
(Date) (Date)

4. Quantity of water claimed and used is 100 gallons per minute; 20 acre feet per year.

5. Purpose or Purposes for which water is used irrigation  
(Domestic, irrigation, municipal, manufacturing, industrial, etc.)

6. Description of Well: Depth 40 feet. Type Drilled  
(Dug or drilled)  
diameter 10 inches. Elevation of ground at well site 175 ft. feet, mean sea level.  
(As near as known)  
Depth to water table 23 feet. Summer

7. Capacity of Well: \_\_\_\_\_ g.p.m. with \_\_\_\_\_ feet drawdown.  
\_\_\_\_\_ g.p.m. with \_\_\_\_\_ feet drawdown.

Date of test Not tested

If Flowing Well: Measured discharge \_\_\_\_\_ g.p.m. on \_\_\_\_\_  
(Date)


Shut-in pressure at ground surface \_\_\_\_\_ lbs. per sq. in. on \_\_\_\_\_  
(Date)

Water is controlled by \_\_\_\_\_  
(Cap, valve, etc.)





Township 9.5 Range 4W, W.M.  
North

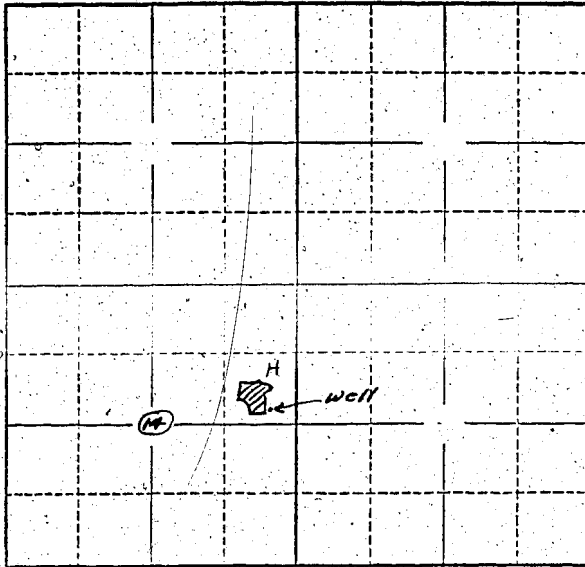

Locate well and acreage of irrigated land on plat.  
Scale: 2" = 1 Mile

STATE OF OREGON }  
County of Marion } ss.

I, Arthur A. Cook, being first duly sworn, do hereby certify that I have read the foregoing Registration Statement and that all of the items therein contained are true to the best of my knowledge and belief.

Arthur A. Cook  
(Signature of Registrant)

Subscribed and sworn to before me this 25th day of March, 1958

My commission expires 12th June 1961 Wm. S. Bartholomew  
(Notary Public)

(SEAL)

CERTIFICATE OF REGISTRATION

STATE OF OREGON }  
County of Marion } ss.

This is to certify that the foregoing Registration Statement was received in the office of the State Engineer on the 10th day of April, 1958, at 4:00 o'clock P. M. and has been duly recorded in said office in Book No. 7 of Registration Statements on page GR-1352

Witness my hand this 14th day of October, 1958

Lewis A. Stanley  
(State Engineer)

By \_\_\_\_\_  
(Deputy)

GR - 1352