

RECEIVED
APR 11 1958
STATE ENGINEER
SALEM, OREGON

Registration No. GR-1397

Certificate No. GR-1353

Registration Statement

OF CLAIMANT OF RIGHT TO APPROPRIATE GROUND WATER

TO THE STATE ENGINEER OF OREGON:

I, ISOM COX
of Rt 1 HARRISBURG County of LANE
(Mailing address)

State of ORE, do hereby make application for a certificate of registration as evidence of a right to appropriate ground water.

- Source from which water is withdrawn is Pump Well
(Flowing well, pump well, infiltration trench, or tunnel)
- Location is: 5 3/4 MILE NW CORBURG
(Approximate distance and direction from nearest city or town)

and is more particularly described as follows:

(a) 677' s & 155' w of center sec. 11
(Give distance and bearing to corner of section or other legal subdivision)
being within n.e. 1/4 S.W. 1/4 of Sec. 11, Twp. 16S, Rge. 4W
(Smallest legal subdivision) (N. or S.) (E. or W.)

or (b) within limits of recorded platted property, town or city:
in Lot _____, Block _____ of _____
(Name of plat or addition)
County of Lane
(If within city or town, give name)

3. Construction Work was begun on July 1945; was completed on same
(Date) (Date)

and the ground water claimed was first used for the purposes set out below on same
(Date)

since which time the water has been used continuously
(Continuously or intermittently)

from May to October
(Date) (Date)

4. Quantity of water claimed and used is 420 gallons per minute; 57.5 acre feet per year.

5. Purpose or Purposes for which water is used IRRIG
(Domestic, irrigation, municipal, manufacturing, industrial, etc.)

6. Description of Well: Depth 20 feet. Type DROVE
(Dug or drilled)
diameter 27 1/4 inches. Elevation of ground at well site 240 feet, mean sea level.
(As near as known)

Depth to water table 9 feet.

7. Capacity of Well: _____ g.p.m. with _____ feet drawdown.
_____ g.p.m. with _____ feet drawdown.

Date of test _____

If Flowing Well: Measured discharge _____ g.p.m. on _____
(Date)

Shut-in pressure at ground surface _____ lbs. per sq. in. on _____
(Date)

Water is controlled by _____
(Cap, valve, etc.)

8. Casing: (Give diameter, commercial specifications and depth below ground surface of each casing size.)

2 (4) inch diameter Steel from 0 to 20 feet
..... inch diameter from to feet
..... inch diameter from to feet
..... inch diameter from to feet

Describe and show depth of shoe, plug, adapter, liner or other details:

9. Perforated Casings or Screens:

Slot from 14 to 20
(Number per foot and size of perforations, or describe screen)
..... from to
..... from to
..... from to

10. Log of Well: (Describe each stratum or formation clearly, indicate if water bearing, and give thickness and depth as indicated.)

MATERIAL	Thickness (Feet)	Depth to Bottom (Feet)
None		

If log of well is not available, give name and address of driller.

11. Infiltration Trench: Covered or open

Dimensions: Length ft. Minimum depth ft. Maximum depth ft.

Bottom width ft. Discharge g.p.m. Date of test

12. Tunnel: Type of lining

Dimensions:
(Length, course, and cross sectional size)

Position of water bearing stratum with reference to portal of tunnel

Log of tunnel: (Preceding table for log of well may be used, if desired. Give footage from portal and character of materials, as pertinent.)

13. Pumping Equipment:

(a) Pump FAIRBANKS MORSE Cent 4" Capacity 420 g.p.m.
(Make, type and size)


(b) Motor 25 H.P. E.C. 3 phase
(Type and horsepower)

14. Location of area irrigated or to be irrigated, or place of use if for purposes other than irrigation.

Township North or South	Range E. or W. of Williams's Meridian	Section	Forty-acre Tract	Number Acres To Be Irrigated	Date of Reclamation
16s	4w	11	NW ¼ SE ¼	9.5	July 1945
16s	4w	11	NE ¼ SW ¼	13.1	" "
				<u>22.7</u>	

15. If the ground water supply is supplemental to an existing water supply, identification of any application for a permit, permit, certificate or adjudicated right to appropriate water made or held by the registrant.

Township 16S Range 4W, W.M.
North

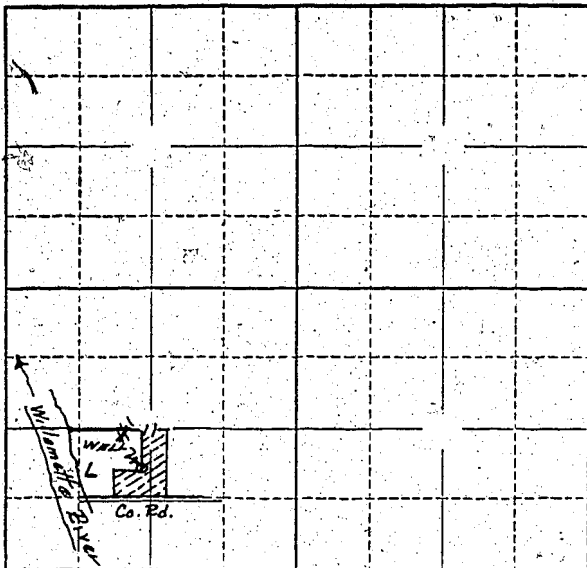

Locate well and acreage of irrigated land on plat.
Scale: 2" = 1 Mile

STATE OF OREGON

County of Lane

ss.

I, Isom Cox, being first duly sworn, do hereby certify that I have read the foregoing Registration Statement and that all of the items therein contained are true to the best of my knowledge and belief.

Isom Cox
(Signature of Registrant)

Subscribed and sworn to before me this 10th day of April, 1958.

My commission expires Jan. 12, 1960

[Signature]
(Notary Public)

(SEAL)

CERTIFICATE OF REGISTRATION

STATE OF OREGON

County of Marion

ss.

This is to certify that the foregoing Registration Statement was received in the office of the State Engineer on the 11th day of April, 1958, at 8:00 o'clock A. M. and has been duly recorded in said office in Book No. 7 of Registration Statements on page GR-1253

Witness my hand this 20th day of October, 1958.

Lewis A. Stanley
(State Engineer)

By _____
(Deputy)