

PRAIRIE WELL
RECEIVED
APR 11 1958
STATE ENGINEER
SALEM, OREGON

Registration No. GR. - 1398
Certificate No. GR. - 1354

Registration Statement

OF CLAIMANT OF RIGHT TO APPROPRIATE GROUND WATER

TO THE STATE ENGINEER OF OREGON:

I, ISOM Cox
of Rt 1 HARRISBURG County of LANE
(Mailing address)
State of OREGON, do hereby make application for a certificate of registration as evidence of a right to appropriate ground water.

1. Source from which water is withdrawn is Pump Well #2
(Flowing well, pump well, infiltration trench, or tunnel)
2. Location is: 5 MILE N.W. Coring
(Approximate distance and direction from nearest city or town)

and is more particularly described as follows:

(a) W 1005'S 327' from Center Sec. 12
(Give distance and bearing to corner of section or other legal subdivision)
being within NE 1/4 SW 1/4 of Sec. 12, Twp. 16 S, Rge. 4 W
(Smallest legal subdivision) (T. or S.) (E. or W.)
or (b) within limits of recorded platted property, town or city:

in Lot _____ Block _____ of _____
(Name of plat or addition)
County of LANE
(If within city or town, give name)

3. Construction Work was begun on APRIL 1955; was completed on APRIL 1955
(Date) (Date)
and the ground water claimed was first used for the purposes set out below on APRIL 1955,
(Date)
since which time the water has been used _____
(Continuously or intermittently)
from MAY to OCT
(Date) (Date)

4. Quantity of water claimed and used is 200 gallons per minute; 47.5 acre feet per year.

5. Purpose or Purposes for which water is used IRRIG
(Domestic, irrigation, municipal, manufacturing, industrial, etc.)

6. Description of Well: Depth 45 feet. Type DRILLED
(Dug or drilled)
diameter 5 inches. Elevation of ground at well site 340 feet, mean sea level.
(As near as known)
Depth to water table 16 feet.

7. Capacity of Well: _____ g.p.m. with _____ feet drawdown.
_____ g.p.m. with _____ feet drawdown.


Date of test _____

If Flowing Well: Measured discharge _____ g.p.m. on _____
(Date)

Shut-in pressure at ground surface _____ lbs. per sq. in. on _____
(Date)

Water is controlled by _____
(Cap, valve, etc.)

Township 16S Range 4W, W.M.
North

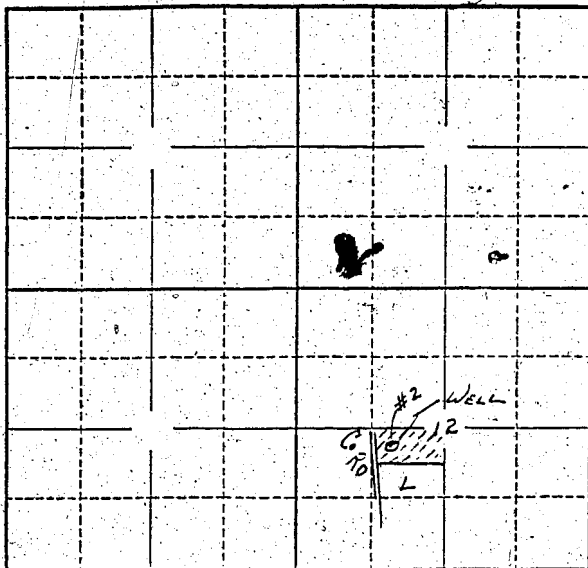

Locate well and acreage of irrigated land on plat.

Scale: 2" = 1 Mile

STATE OF OREGON

County of Lane

ss.

I, Isom Cox, being first duly sworn, do hereby certify that I have read the foregoing Registration Statement and that all of the items therein contained are true to the best of my knowledge and belief.

Isom Cox
(Signature of Registrant)

Subscribed and sworn to before me this 10th day of April, 1958.

My commission expires Jan. 12, 1960

Debbie Jones
(Notary Public)

(SEAL)

CERTIFICATE OF REGISTRATION

STATE OF OREGON

County of Marion

ss.

This is to certify that the foregoing Registration Statement was received in the office of the State Engineer on the 11th day of April, 1958, at 8:00 o'clock A. M. and has been duly recorded in said office in Book No. 7 of Registration Statements on page GR-1354

Witness my hand this 20th day of October, 1958

Lewis A. Stanley
(State Engineer)

By _____
(Deputy)