

Registration Statement

REGISTRATION NO. GR-140CERTIFICATE NO. GR-330

OF CLAIMANT OF RIGHT TO APPROPRIATE GROUND WATER

(Under Chapter 708, Oregon Laws 1955.)

TO THE STATE ENGINEER OF OREGON:

I, John B. Woods & Son P.O. Box 647
of Salem County of MarionState of Oregon, do hereby make application for a certificate of registration as evidence of a right to appropriate ground water.1. Source from which water is withdrawn is Pump Well
(Flowing well, pump well, infiltration trench, or tunnel)2. Location is: 5 Miles South of Salem City Limits
(Approximate distance and direction from nearest city or town)

and is more particularly described as follows:

(a) 1/4th N and 3/4th E of SW corner of Sect 15
SE 1/4 of SW 1/4
being within Lon's Hill Fruit Tract Lots 247 Sec. 15, Twp. P. 5, Rge. 3 E
(Smallest legal subdivision) (N. or S.) (E. or W.)

or (b) within limits of recorded platted property, town or city:

in Lot _____, Block _____ of _____
(Name of plat or addition)County of Marion
(If within city or town, give name)3. Construction Work was begun on March 15th, 1955; was completed on March 22nd, 1955
(Date) (Date)and the ground water claimed was first used for the purposes set out below on May 15th, 1955
(Date)since which time the water has been used Intermittently
(Continuously or Intermittently)from May 1955 to Date
(Date) (Date)4. Quantity of water claimed and used is 60 gallons per minute; _____ acre feet per year.5. Purpose or Purposes for which water is used Irrigation


(Domestic, irrigation, municipal, manufacturing, industrial, etc.)

6. Description of Well: Depth _____ feet. Type Drilled
(Dug or drilled)diameter _____ inches. Elevation of ground at well site approx. 550 feet, mean sea level.
(As near as known)Depth to water table 77 feet.7. Capacity of Well: 60 g.p.m. with 27 feet drawdown.

_____ g.p.m. with _____ feet drawdown:

Date of test April 21, 1955If Flowing Well: Measured discharge _____ g.p.m. on _____
(Date)Shut-in pressure at ground surface _____ lbs. per sq. in. on _____
(Date)Water is controlled by _____
(Cap, valve, etc.)

Township P 5 Range 3 661, W.M.
North

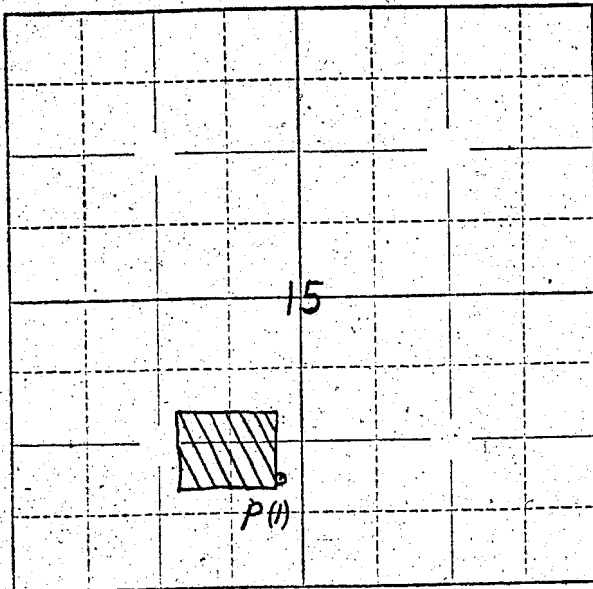

8/30-15 P(1)

Locate well and acreage of irrigated land on plat.

Scale: $\frac{1}{4}$ = 1 Mile

STATE OF OREGON

County of _____ } ss.


John B. Winters
(Signature of Registrant)

Subscribed and sworn to before me this 13 day of March, 1957.

My commission expires September 2, 1960
Mar. St. Rogers
(Notary Public)

(SEAL)

CERTIFICATE OF REGISTRATION

STATE OF OREGON

County of Marion } ss.

This is to certify that the foregoing Registration Statement was received in the office of the State Engineer on the 6th day of March, 1956, at 8:00 o'clock A. M. and has been duly recorded in said office in Book No. 2 of Registration Statements on page GR-330 10

~~X Construction shall be completed by 10-1-57 and the water completely applied to beneficial use by 10-1-57~~

Witness my hand this 1st day of April, 1957.

Lewis A. Stanley
(State Engineer)

By _____ (Deputy)

GR-330C

11501