

RECEIVED

APR 11 1958

STATE ENGINEER
SALEM, OREGON

REGISTRATION NO. GR-1403

CERTIFICATE NO. GR-1358

Registration Statement

OF CLAIMANT OF RIGHT TO APPROPRIATE GROUND WATER

(Under Chapter 708, Oregon Laws 1955.)

TO THE STATE ENGINEER OF OREGON:

I, We Mr & Mrs Alfred Q. Tiplar
 of Portland County of Multnomah
 State of Oregon, do hereby make application for a certificate of registration as evidence
 of a right to appropriate ground water.

1. Source from which water is withdrawn is pump well
(Flowing well, pump well, infiltration trench, or tunnel)
 2. Location is: 3 miles east of Parkrose, Ore
(Approximate distance and direction from nearest city or town)

and is more particularly described as follows:

- (a) approx 308' South & 220' West
(Give distance and bearing to corner of section or other legal subdivision)
 being within SE 1/4 of NE 1/4 of Sec. 30, Twp. 1 N, Rge. 3 E
(Smallest legal subdivision) (N. or S.) (E. or W.)
 or (b) within limits of recorded platted property, town or city:

in Lot _____, Block _____ of _____
(If within city or town, give name) County of Multnomah

3. Construction Work was begun on June 4 1954 was completed on Aug 2 1954
(Date) (Date)

and the ground water claimed was first used for the purposes set out below on Aug 2 1954
(Date)
 since which time the water has been used intermittently
(Continuously or Intermittently)
 from Aug 2 1954 to Aug 2 1954
(Date) (Date)

4. Quantity of water claimed and used is 300 gallons per minute; 300 acre
 feet per year.

5. Purpose or Purposes for which water is used Domestic & irrigation
(Domestic, irrigation, municipal, manufacturing, industrial, etc.)

6. Description of Well: Depth 390 feet. Type drilled
(Dig or drilled)
 diameter 8 inches. Elevation of ground at well site 40 feet, mean sea level.
(As near as known)
 Depth to water table 3110 feet. Static water level

7. Capacity of Well: 300 g.p.m. with 40 feet drawdown.
530 g.p.m. with 62 feet drawdown.

Date of test Aug 2, 1954

If Flowing Well: Measured discharge _____ g.p.m. on _____
(Date)

Shut-in pressure at ground surface _____ lbs. per sq. in. on _____
(Date)

Water is controlled by _____
(Cap, valve, etc.)

size.)

10"	inch diameter	Standard Black Lead pipe	from 0	to 122	feet
8"	inch diameter	" " " "	from 0	to 357	feet
	inch diameter		from	to	feet
	inch diameter		from	to	feet

Describe and show depth of shoe, plug, adapter, liner or other details: The 8" pipe is with 10" pipe. The 8" standard black steel pipe with the shoe is driven into the black sand and a total length of pipe installed 357 ft 9".

At the 250pm & 500pm water	from	to
(Number per foot and size of perforations, or describe screen)		
is carried off, is not perforated	from	to
The water from the 366' to 390'	from	to
is taken	from	to

10. **Log of Well:** (Describe each stratum or formation clearly, indicate if water bearing, and give thickness and depth as indicated.)

	MATERIAL	Thickness (Feet)	Depth to Bottom (Feet)
0 - 4	top soil		
4 - 60	yellow clay & boulders		
60 - 116	consolidated gravel		
116 - 120	water gravel & boulders 12.5 gals		
120 - 123	large boulders, stones 10 gals		
123 - 187	consolidated gravel		
187 - 245	coarser blue gravel	9	
	(first test pump - 10 gals)		
245 - 266	sand	10	
266 - 305	blue		
305 - 310	brown clay	6	
310 - 337	loamy blue		
337 - 353	blue clay		
353 - 366	loamy black mud & gravel		
366 - 391	broken lava with fragments		
	test pumped 330 gals		

GR-1358

If log of well is not available, give name and address of driller. Harker & Butter

11544 NE Glisan Portland, Ore

11. Infiltration Trench: Covered or open

Dimensions: Length ft. Minimum depth ft. Maximum depth ft.

Bottom width ft. Discharge g.p.m. Date of test

12. Tunnel: Type of lining _____

Dimensions: _____
(Length, course, and cross sectional size)

Position of water bearing stratum with reference to portal of tunnel

Log of tunnel: (Preceding table for log of well may be used, if desired. Give footage from portal and character of materials, as pertinent.)

13. Pumping Equipment:

(a) Pump Yokohama 10 horse Capacity 300 g.p.m.


(b) Motor L.E. 30 H.P. hollow shaft continuous 3 phase
(Type and horsepower)

14. Location of area irrigated or to be irrigated, or place of use if for purposes other than irrigation.

[illegible]

15. If the ground water supply is supplemental to an existing water supply, identification of any application for a permit, permit, certificate or adjudicated right to appropriate water made or held by the registrant.

Township 1 N Range 3 E W.M.
North

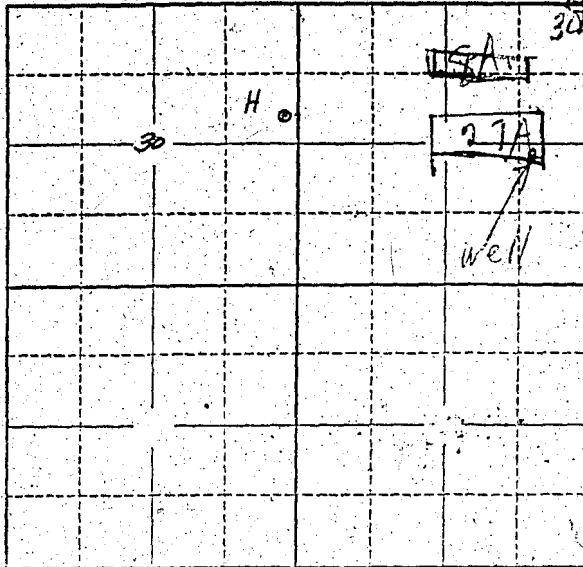

Locate well and acreage of irrigated land on plat.

Scale: 2" = 1 Mile

STATE OF OREGON

County of Multnomah } ss.

I, Alfred G. Aplan, being first duly sworn, do hereby certify that I have read the foregoing Registration Statement and that all of the items therein contained are true to the best of my knowledge and belief.

Alfred G. Aplan
(Signature of Registrant)

Subscribed and sworn to before me this 10th day of April, 1958

My commission expires Jan. 11, 1961

SE
(Notary Public)

(SEAL)

CERTIFICATE OF REGISTRATION

STATE OF OREGON }
County of Marion } ss.

This is to certify that the foregoing Registration Statement was received in the office of the State Engineer on the 11th day of April, 1958, at 1.00 o'clock P. M. and has been duly recorded in said office in Book No. 7 of Registration Statements on page GR-1358

~~Construction shall be completed by _____, 19____, and the water completely applied to _____
_____ by _____~~

Witness my hand this 20th day of October, 1958

Lewis A. Stanley
(State Engineer)

By _____
(Deputy)

GR-1358