

RECEIVED
APR 15 1958
STATE ENGINEER
SALEM, OREGON

Registration No. GR - 1408
Certificate No. GR - 1263

Registration Statement

OF CLAIMANT OF RIGHT TO APPROPRIATE GROUND WATER

TO THE STATE ENGINEER OF OREGON:

I, Charles C. Vogel and Lottie R. Vogel
of Route 2 Eugene Bay - 464 County of Laine
(Mailing address)

State of Oregon, do hereby make application for a certificate of registration as evidence of a right to appropriate ground water.

- 1. Source from which water is withdrawn is pump well
(Flowing well, pump well, infiltration trench, or tunnel)
- 2. Location is: 2 1/2 miles N.W. of Coburg Ore
(Approximate distance and direction from nearest city or town)

and is more particularly described as follows:

(a) 2843.3 ft East and 540 ft North from West 1/4 corner
(Give distance and bearing to corner of section or other legal subdivision)
being within SE 1/4 NW 1/4 of Sec. 19, Twp. 16-S, Rge. 3-N-W.M.
(Smallest legal subdivision) (N. or S.) (E. or W.)

or (b) within limits of recorded platted property, town or city.

in Lot _____ Block _____ of _____
(Name of plat or addition)

County of Laine
(If within city or town, give name)

3. Construction Work was begun on about May 10, 1952; was completed on 18th May 1952
(Date) (Date)

and the ground water claimed was first used for the purposes set-out below on June 15th 1952
(Date)

since which time the water has been used continuously
(Continuously or intermittently)

from June to October
(Date) (Date)

4. Quantity of water claimed and used is 180 gallons per minute; _____ acre feet per year.

5. Purpose or Purposes for which water is used irrigation
(Domestic, irrigation, municipal, manufacturing, industrial, etc.)

6. Description of Well: Depth 47 feet. Type Drilled
(Dug or drilled)

diameter 6 inches. Elevation of ground at well site 485 feet, mean sea level.
(As near as known)

Depth to water table 10 feet.

7. Capacity of Well: 180 g.p.m. with 16 feet drawdown.
_____ g.p.m. with _____ feet drawdown.


Date of test May 18 - 52

If Flowing Well: Measured discharge _____ g.p.m. on _____
(Date)

Shut-in pressure at ground surface _____ lbs. per sq. in. on _____
(Date)

Water is controlled by _____
(Cap, valve, etc.)

Township 16S Range 3W, W.M.
North

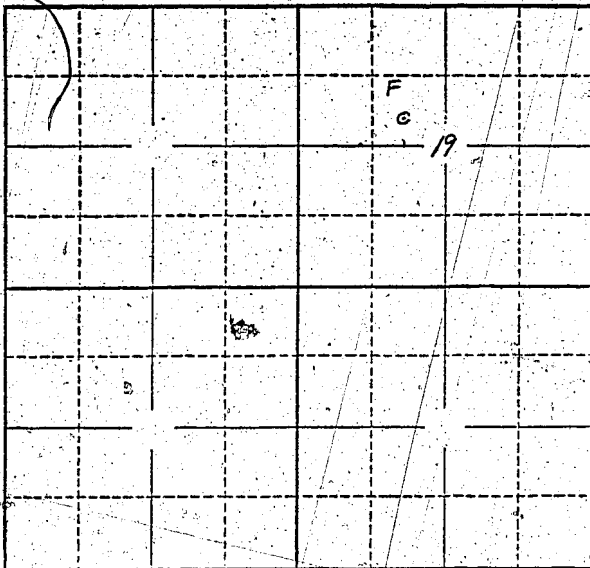

Locate well and acreage of irrigated land on plat.
Scale: 2" = 1 Mile

STATE OF OREGON

County of Marion

} ss.

Charles E. Vogel, being first duly sworn, do hereby certify that I have read the foregoing Registration Statement and that all of the items therein contained are true to the best of my knowledge and belief.

Charles E. Vogel
(Signature of Registrant)

Subscribed and sworn to before me this 16 day of April, 1958

My commission expires 2-16-1959

[Signature]
(Notary Public)

(SEAL)

CERTIFICATE OF REGISTRATION

STATE OF OREGON

County of Marion

} ss.

This is to certify that the foregoing Registration Statement was received in the office of the State Engineer on the 15th day of April, 1958, at 8:00 o'clock A. M. and has been duly recorded in said office in Book No. 7 of Registration Statements on page GR-1363

Witness my hand this 20th day of October, 1958

Lewis A. Stanley
(State Engineer)

By _____ (Deputy)

#15-20