

Registration Statement

OF CLAIMANT OF RIGHT TO APPROPRIATE GROUND WATER

(Under Chapter 708, Oregon Laws 1955.)

TO THE STATE ENGINEER OF OREGON:

I, Harold E. Wilde & Dorothy M. Wilde or the survivor of either
of Junction City County of Lane

State of Oregon, do hereby make application for a certificate of registration as evidence of a right to appropriate ground water.

1. Source from which water is withdrawn is Pump well
(Flowing well, pump well, infiltration trench, or tunnel)

2. Location is: 1 1/2 miles east of Junction City Ore.
(Approximate distance and direction from nearest city or town)

and is more particularly described as follows:

(a) Well located 260 ft east and 800 ft south of N 1/4 corner section 33.
950 ft from East LINE and 400 ft from South Line which borders DANE LANE
(Give distance and bearing to corner of section or other legal subdivision)

being within legal description attached NW 1/4 of NE of Sec. 33, Twp. 15 South, Rge. 4 west
(Smallest legal subdivision) (N. or S.) (E. or W.)

or (b) within limits of recorded platted property, town or city:

in Lot 12, Block _____ of Milletts Plat
(Name of plat or addition)

County of Lane
(If within city or town, give name)

3. Construction Work was begun on June 20, 1950; was completed on July 15, 1950
(Date) (Date)

and the ground water claimed was first used for the purposes set out below on July 16, 1950
(Date)

since which time the water has been used Intermittently
(Continuously or Intermittently)

from about April 10 to about Oct 1 depending on season
(Date) (Date)

4. Quantity of water claimed and used is 300 gallons per minute; 12.5 acre feet per year.

5. Purpose or Purposes for which water is used irrigation
(Domestic, irrigation, municipal, manufacturing, industrial, etc.)

6. Description of Well: Depth 23 feet. Type driven
(Dug or drilled)

diameter 4 inches. Elevation of ground at well site 316 feet, mean sea level.
(As near as known)

Depth to water table 12 1/2 feet. summer average

7. Capacity of Well: 200 g.p.m. with 7 feet drawdown.

_____ g.p.m. with _____ feet drawdown.

Date of test July 16, 1950

If Flowing Well: Measured discharge _____ g.p.m. on _____
(Date)

Shut-in pressure at ground surface _____ lbs. per sq. in. on _____
(Date)

Water is controlled by _____
(Cap, valve, etc.)

If log of well is not available, give name and address of driller. *Walter Nelson*

680 Maple St Junction City Oregon

11. Infiltration Trench: Covered or open
Dimensions: Length ft. Minimum depth ft. Maximum depth ft.
Bottom width ft. Discharge g.p.m. Date of test

12. Tunnel: Type of lining
Dimensions:
(Length, course, and cross sectional size)
Position of water bearing stratum with reference to portal of tunnel

Log of tunnel: (Preceding table for log of well may be used, if desired. Give footage from portal and character of materials, as pertinent.)

13. Pumping Equipment:
(a) Pump *Cornell 2 1/2 X 3 in Centrifugal* Capacity *300* g.p.m.
(b) Motor *electric 10 horse*
(Type and horsepower)

14. Location of area irrigated or to be irrigated, or place of use if for purposes other than irrigation.


Township North or South	Range E. or W. of Willamette Meridian	Section	Forty-acre Tract	Number Acres To Be Irrigated	Date of Reclamation
<i>15 South</i>	<i>4 West</i>	<i>33</i>	<i>NW 1/4 of NE 1/4</i>	<i>40</i>	<i>1950</i>
			<i>NE 1/4 of NW 1/4</i>	<i>10</i>	<i>"</i>

RECEIVED
MAR 6 1956
STATE ENGINEER
SALEM, OREGON

Beginning at a point in the south line of Lot No. 12 of Milletta Plat in Section 33, Township 15 South, Range 4 West of The Willamette Meridian in Lane County, Oregon 5.96 chains North 89° 25' West from the Southeast corner thereof; thence North 20 chains; thence North 89° 25' West 21.73 chains; thence South 75 links; thence North 89° 25' West 6.31 chains to the West line of said Lot No. 12; thence Southwesterly along said West line to the Southwest corner of said Lot 12; thence South 89° 25' East 27.04 chains to the place of beginning, containing 52.40 acres, more or less, in Lane County, Oregon.

15. If the ground water supply is supplemental to an existing water supply, identification of any application for a permit, permit, certificate or adjudicated right to appropriate water made or held by the registrant.

Township 15 S Range 4 W, W.M.
North

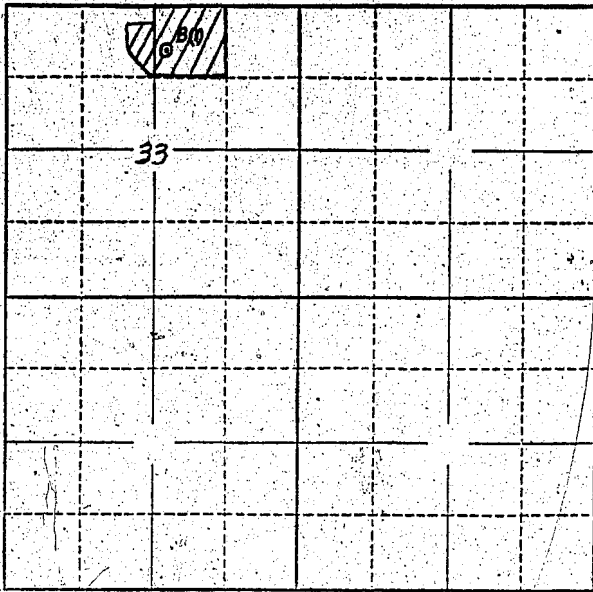

Locate well and acreage of irrigated land on plat.
Scale: 2" = 1 Mile

STATE OF OREGON

County of LANE

} ss.

I, Harold E. Wilde, being first duly sworn, do hereby certify that I have read the foregoing Registration Statement and that all of the items therein contained are true to the best of my knowledge and belief.

Harold E. Wilde

(Signature of Registrant)

Subscribed and sworn to before me this 5th day of March, 1956

My commission expires January 21, 1957

Subscribed on

(Notary Public)

(SEAL)

CERTIFICATE OF REGISTRATION

STATE OF OREGON

County of Marion

} ss.

This is to certify that the foregoing Registration Statement was received in the office of the State Engineer on the 6th day of March, 1956, at 6 o'clock P.M. and has been duly recorded in said office in Book No. 1 of Registration Statements on page GR-135 C

~~Construction shall be completed by _____ and the water completely applied to beneficial use by _____~~

Witness my hand this 8th day of October, 1956

Lewis A. Stanley

(State Engineer)

By _____

(Deputy)

GR-135 C