

RECEIVED
APR 16 1958
STATE ENGINEER
SALEM, OREGON

Registration No. GR - 1412
Certificate No. GR - 1366

Registration Statement

OF CLAIMANT OF RIGHT TO APPROPRIATE GROUND WATER

TO THE STATE ENGINEER OF OREGON:

I, Klaer and Georgia Heyerly
of Rt. 2, Box 505 C, Albany County of Linn
(Mailing address)

State of Oregon, do hereby make application for a certificate of registration as evidence of a right to appropriate ground water.

- Source from which water is withdrawn is Pump well
(Flowing well, pump well, infiltration trench, or tunnel)
- Location is: 9 miles NE of Albany, Oregon
(Approximate distance and direction from nearest city or town)

and is more particularly described as follows:

(a) N. 80° 20' W. 12 chains from NW corner DLC 42, T. 10 S, R. 2 W.W.M.
(Give distance and bearing to corner of section or other legal subdivision)
being within SE 1/4 of NW 1/4 of Sec. 30, Twp. 10 S, Rge. 2 W
(Smallest legal subdivision) (N. or S.) (E. or W.)
or (b) within limits of recorded platted property, town or city:
in Lot _____, Block _____ of _____
(Name of plat or addition)
County of Linn
(If within city or town, give name)

3. Construction Work was begun on 1950; was completed on 1950
(Date) (Date)
and the ground water claimed was first used for the purposes set out below on 1950
(Date)
since which time the water has been used continuously
(Continuously or intermittently)
from 1950 to present time
(Date) (Date)

4. Quantity of water claimed and used is 312 gallons per minute; 115.0 acre feet per year.

5. Purpose or Purposes for which water is used Irrigation
(Domestic, irrigation, municipal, manufacturing, industrial, etc.)

6. Description of Well: Depth 30 feet. Type Drilled
(Dug or drilled)
diameter 10 inches. Elevation of ground at well site 230 feet, mean sea level.
(As near as known)
Depth to water table 10 feet.

7. Capacity of Well: 450 g.p.m. with 3 feet drawdown.
_____ g.p.m. with _____ feet drawdown.

Date of test 1950

If Flowing Well: Measured discharge _____ g.p.m. on _____
(Date)

Shut-in pressure at ground surface _____ lbs. per sq. in. on _____
(Date)

Water is controlled by _____
(Cap, valve, etc.)

8. Casing: (Give diameter, commercial specifications and depth below ground surface of each casing size.)

10 inch diameter **steel casing** from 0 to 30 feet
 inch diameter from to feet
 inch diameter from to feet
 inch diameter from to feet

Describe and show depth of shoe, plug, adapter, liner or other details: _____

9. Perforated Casings or Screens:

Slot perforations from 22 to 30
(Number per foot and size of perforations, or describe screen)
 from to
 from to
 from to

10. Log of Well: (Describe each stratum or formation clearly, indicate if water bearing, and give thickness and depth as indicated.)

MATERIAL	Thickness (Feet)	Depth to Bottom (Feet)
Not available		

If log of well is not available, give name and address of driller. Unknown

11. Infiltration Trench: Covered or open

Dimensions: Length ft. Minimum depth ft. Maximum depth ft.

Bottom width ft. Discharge g.p.m. Date of test

12. Tunnel: Type of lining

Dimensions:
(Length, course, and cross sectional size)

Position of water bearing stratum with reference to portal of tunnel

Log of tunnel: (Preceding table for log of well may be used, if desired. Give footage from portal and character of materials, as pertinent.)

13. Pumping Equipment:

(a) Pump Myers 3" centrifugal Capacity 450 g.p.m.
(Make, type and size)

(b) Motor 20 H. P. Electric
(Type and horsepower)

14. Location of area irrigated or to be irrigated, or place of use if for purposes other than irrigation.

Township North or South	Range E. or W. of Willamette Meridian	Section	Forty-acre Tract	Number Acres To Be Irrigated	Date of Reclamation
10 S	2 W	30	NW $\frac{1}{4}$ of NE $\frac{1}{4}$	0.3	1950
10 S	2 W	30	NE $\frac{1}{4}$ of NW $\frac{1}{4}$	10.8	"
10 S	2 W	30	NW $\frac{1}{4}$ of NW $\frac{1}{4}$	0.1	"
10 S	2 W	30	SW $\frac{1}{4}$ of NW $\frac{1}{4}$	16.2	"
10 S	2 W	30	SE $\frac{1}{4}$ of NW $\frac{1}{4}$	18.6	"
				46.0	

Earl A. Miller 235-69

The following described real property situate in Linn County, State of Oregon:


Tract I: beginning at a point on the west boundary line of and North 33.24 chains distant from the southwest corner of the Wm. H. Bayse D.L.C. lot # 1625 and claim #63 in T. 11 S., R. 3 W. of the Will. Mer. in Linn County, Oregon; thence East 27.52 chains; thence N. 19° 45' E. 14.03 chains to the North line of Claim #41 in T. 10 S., R. 2 W. of the Will. Mer.; thence N. 71° 10' W. 12.84 chains to the Southwest corner of Claim # 42 in said Township and Range; thence S. 19° 45' E. 2.91 chains to the interior corner on the North line of said Claim # 41; thence West 15 links to the South line of the Corvallis and Eastern railroad right of way; thence S. 61° 40' W. 21.30 chains along the South line of said right of way to the West line of said Claim # 77 in T. 10 S., R. 3 W. of the Will. Mer.; thence South 40 chains to the point of beginning; SAVE and EXCEPT the Railroad right of way to the north as described by deed recorded in Book 35, page 419, Deed Records on August 9, 1899; and subject to the right of the public in roads.

Tract II: beginning 0.25 chains north and 10.25 chains East of the quarter section corner on the West boundary line of Section 30, T. 10 S., R. 2 W. of the Will. Mer. in Linn County, Oregon; thence East 23.00 chains to the West line of the William Earl D.L.C. # 42 in said Township and Range; thence N. 19° 20' E. 23.30 chains to the left bank of the South Santiam river; thence following said bank in a Southwesterly direction to a point due North of the place of beginning; thence South 0.00 chains to the place of beginning.

--	--	--	--	--	--

15. If the ground water supply is supplemental to an existing water supply, identification of any application for a permit, permit, certificate or adjudicated right to appropriate water made or held by the registrant.

Township 10 S Range 2 W, W.M.
North

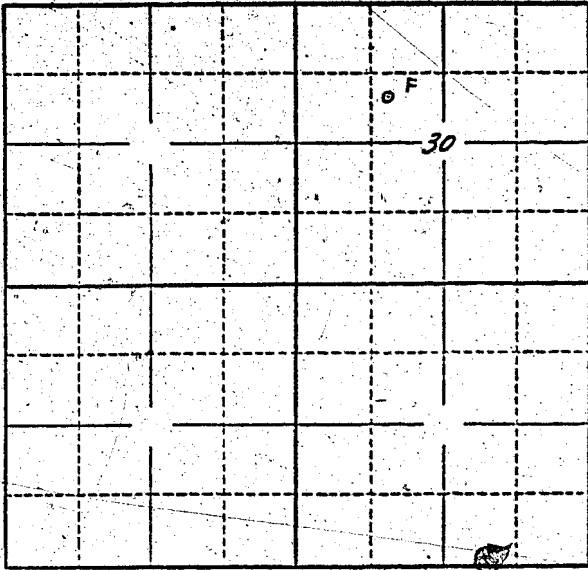

Locate well and acreage of irrigated land on plat.
Scale: 2" = 1 Mile

STATE OF OREGON

County of LINN

I, Elmer and Georgia Heyerly being first duly sworn, do hereby certify that I have read the foregoing Registration Statement and that all of the items therein contained are true to the best of my knowledge and belief.

Elmer Heyerly
Georgia Heyerly
(Signature of Registrant)

Subscribed and sworn to before me this 12 day of June, 1958

My commission expires 7-6-58

[Signature]
(Deputy Public)

(SEAL)

CERTIFICATE OF REGISTRATION

STATE OF OREGON

County of Marion

This is to certify that the foregoing Registration Statement was received in the office of the State Engineer on the 16th day of April, 1958, at 11 o'clock A.M. and has been duly recorded in said office in Book No. 7 of Registration Statements on page GR-1366

Witness my hand this 20th day of October, 1958

Lewis A. Stanley
(State Engineer)

By _____ (Deputy)

#1740