

RECEIVED

APR 16 1958

STATE ENGINEER
SALEM, OREGON

REGISTRATION NO. GR-1416

Registration Statement CERTIFICATE NO. GR-1370

OF CLAIMANT OF RIGHT TO APPROPRIATE GROUND WATER

(Under Chapter 708, Oregon Laws 1955.)

TO THE STATE ENGINEER OF OREGON:

I, Dale Stocking

of Cornelius County of Washington

State of Oregon, do hereby make application for a certificate of registration as evidence of a right to appropriate ground water.

1. Source from which water is withdrawn is Pump well

(Flowing well, pump well, infiltration trench, or tunnel)

2. Location is: 1/2 mi. W. of Cornelius

(Approximate distance and direction from nearest city or town)

and is more particularly described as follows:

(a) 320' West + 500' South of the NE corner of SW 1/4 of NW 1/4

(Give distance and bearing to corner of section or other legal subdivision)

being within SW 1/4 of NW 1/4 of Sec. 4, Twp. 15, Rge. 3W

(Smallest legal subdivision)

(N. or S.)

(E. or W.)

or (b) within limits of recorded platted property, town or city:

in Lot _____, Block _____ of _____

(Name of plat or addition)

County of _____

(If within city or town, give name)

3. Construction Work was begun on May 1954; was completed on June 1954

(Date)

(Date)

and the ground water claimed was first used for the purposes set out below on July 1954

(Date)

since which time the water has been used Cont.

(Continuously or intermittently)

from 1954 to Present

(Date)

(Date)

4. Quantity of water claimed and used is 350 G.P.M. gallons per minute; 175 acre

feet per year.

5. Purpose or Purposes for which water is used Irrigation

(Domestic, irrigation, municipal, manufacturing, industrial, etc.)

6. Description of Well: Depth 183 feet. Type Drilled

(Dug or drilled)

diameter 24 inches. Elevation of ground at well site _____ feet, mean sea level.

(As near as known)

Depth to water table 19 feet.

7. Capacity of Well: 630 g.p.m. with 81 feet drawdown.

_____ g.p.m. with _____ feet drawdown.

Date of test June 1954

If Flowing Well: Measured discharge _____ g.p.m. on _____

(Date)

Shut-in pressure at ground surface _____ lbs. per sq. in. on _____

(Date)

Water is controlled by _____

(Cap, valve, etc.)

8. Casing: (Give diameter, commercial specifications and depth below ground surface of each casing size.)

8 ID Steel inch diameter Steel from 0 to 183 feet
 inch diameter from to feet
 inch diameter from to feet
 inch diameter from to feet

Describe and show depth of shoe, plug, adapter, liner or other details:


9. Perforated Casings or Screens:

Torch 1/8 x 12 4 per ft. from 100 to 180
 (Number per foot and size of perforations, or describe screen)
 from to
 from to
 from to

10. Log of Well: (Describe each stratum or formation clearly, indicate if water bearing, and give thickness and depth as indicated.)

MATERIAL	Thickness (Feet)	Depth to Bottom (Feet)
Brown Clay	26	26
Blue Sandy Clay	62	88
Coarse Sand	13	101
Blue Clay	2	103
Coarse Sand	1	104
Hard Blue Clay	13	117
Soft Brown and Yellow Clay	10	127
Coarse Sand	2	129
Blue and Brown Clay	17	146
Coarse Sand and Pea Gravel	9	155
Blue and Brown Clay	8	163
Coarse Sand and Pea Gravel	14	177
Gray and Brown Clay	6	183

Township 15 Range 3W, W.M.
North

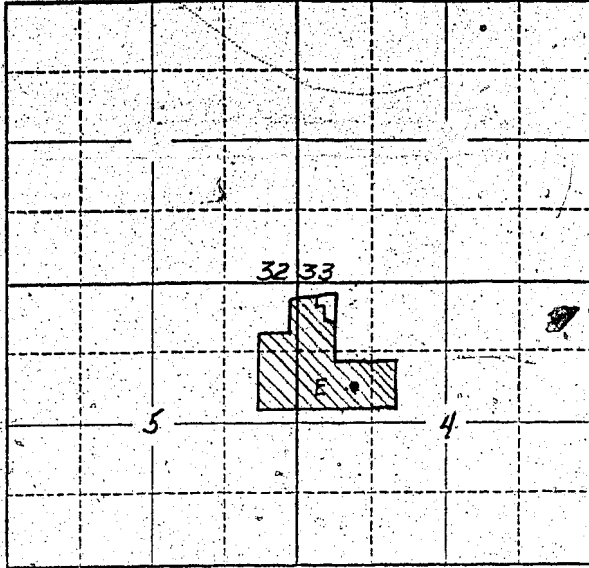

Locate well and acreage of irrigated land on plat.
Scale: 2" = 1 Mile

STATE OF OREGON }
County of Washington } ss.

I, Dale Storking, being first duly sworn, do hereby certify that I have read the foregoing Registration Statement and that all of the items therein contained are true to the best of my knowledge and belief.

Dale Storking
(Signature of Registrant)

Subscribed and sworn to before me this 20th day of February, 1958

My commission expires MARCH 21, 1959
(Notary Public)

(SEAL)

CERTIFICATE OF REGISTRATION

STATE OF OREGON }
County of Marion } ss.

This is to certify that the foregoing Registration Statement was received in the office of the State Engineer on the 16th day of April, 1958, at 8:00 o'clock A.M. and has been duly recorded in said office in Book No. 7 of Registration Statements on page 62-1370

~~Construction shall be completed by _____ 19____ and the water completely applied to beneficial use by _____ 19____.~~

Witness my hand this 20th day of October, 1958.

Leurs J. Stanley
(State Engineer)

By _____
(Deputy)

62-1370

1958