

Registration Statement

RECEIVED
MAR 8 1956OF CLAIMANT OF RIGHT TO APPROPRIATE GROUND WATER
STATE ENGINEER
SALEM, OREGON
(Under Chapter 708, Oregon Laws 1955.)

TO THE STATE ENGINEER OF OREGON:

I, Philip W. and Elizabeth Haddanof Rt. 3, Box 736, Albany County of LinnState of Oregon, do hereby make application for a certificate of registration as evidence of a right to appropriate ground water.1. Source from which water is withdrawn is Pump Wells No. 1 & No. 2

(Flowing well, pump well, infiltration trench, or tunnel)

2. Location is: 5 miles S.W. of Albany, Oregon

(Approximate distance and direction from nearest city or town)

and is more particularly described as follows:

1. S. 27°20' E. 15.75 chains from the NW corner of the Wm. Moore D.L.C. 60

(a) 2. S. 13°50' E. 37.5 chains from the NW corner of the Wm. Moore D.L.C. 60

(Give distance and bearing to corner of section or other legal subdivision)

being within 1. NE $\frac{1}{4}$ of NW $\frac{1}{4}$ of Sec. 22, Twp. 11 S. Rge. 4 W.
2. SE $\frac{1}{4}$ of NW $\frac{1}{4}$
(Smallest legal subdivision) (N. or S.) (E. or W.)

or (b) within limits of recorded platted property, town or city:

in Lot _____, Block _____ of _____
(Name of plat or addition)County of Linn
(If within city or town, give name)3. Construction Work was begun on 1. March 10, 19451. March 15, 19452. June 1, 1948; was completed on 2. June 3, 19481. May 15, 1945and the ground water claimed was first used for the purposes set out below on 2. June 5, 1948
(Date)since which time the water has been used continuously

(Continuously or intermittently)

1. May 15, 1945from 2. June 5, 1948 to present time
(Date) (Date)1. 801. 444. Quantity of water claimed and used is 2. 100 gallons per minute; 2. 78 acre
feet per year.5. Purpose or Purposes for which water is used Irrigation

(Domestic, irrigation, municipal, manufacturing, industrial, etc.)

6. Description of Well: Depth 1. 30 feet. Type drilled

(Dug or drilled)

diameter 1. 6 inches. Elevation of ground at well site 205 feet, mean sea level.
2. 8
(As near as known)Depth to water table 2. 10 feet.7. Capacity of Well: 1. 80 g.p.m. with 20 feet drawdown.2. 100 g.p.m. with 20 feet drawdown.Date of test Not testedIf Flowing Well: Measured discharge _____ g.p.m. on _____
(Date)Shut-in pressure at ground surface _____ lbs. per sq. in. on _____
(Date)Water is controlled by _____
(Cap, valve, etc.)

8. Casing: (Give diameter, commercial specifications and depth below ground surface of each casing size.)

- 1. 6 inch diameter Steel casing from 0 to 30 feet
- 2. 8 inch diameter Steel casing from 0 to 31 feet
- inch diameter from to feet
- inch diameter from to feet

Describe and show depth of shoe, plug, adapter, liner or other details:

.....

9. Perforated Casings or Screens:

- 1. Slit perforations from 20 to 30
(Number per foot and size of perforations, or describe screen)
- 2. Slit perforations from 12 to 31
- from to
- from to

10. Log of Well: (Describe each stratum or formation clearly, indicate if water bearing, and give thickness and depth as indicated.)

MATERIAL	Thickness (Feet)	Depth to Bottom (Feet)
Not available		

If log of well is not available, give name and address of driller: 1. Reginald Glassy, Rt. 4, Albany, Ore.

2. C. W. Shaffer, Philomath, Oregon

11. Infiltration Trench: Covered or open

Dimensions: Length _____ ft. Minimum depth _____ ft. Maximum depth _____ ft.
Bottom width _____ ft. Discharge _____ g.p.m. Date of test _____

12. Tunnel: Type of lining

Dimensions: _____
(Length, course, and cross sectional size)

Position of water bearing stratum with reference to portal of tunnel _____

Log of tunnel: (Preceding table for log of well may be used, if desired. Give footage from portal and character of materials, as pertinent.)

13. Pumping Equipment:

- (a) Pump 1. 1 1/2" centrifugal 1. 80
2. 1 1/2" centrifugal Fairbanks Morse Capacity 2. 100 g.p.m.
(Make, type and size)
(b) Motor 1. 7 1/2 H.P. electric motor
2. 5 H.P. electric motor
(Type and horsepower)

14. Location of area irrigated or to be irrigated, or place of use if for purposes other than irrigation.

Township North or South	Range E. or W. of Williamette Meridian	Section	Forty-acre Tract	Number Acres To Be Irrigated	Date of Reclamation
11 S.	4 W.	22	NE 1/4 of NW 1/4	14.0	May 15, 1945
11 S.	4 W.	22	NW 1/4 of NE 1/4	3.5	May 15, 1945
2. 11 S.	4 W.	22	NE 1/4 of NW 1/4	6.0	June 5, 1948
11 S.	4 W.	22	NW 1/4 of NE 1/4	6.0	June 5, 1948
11 S.	4 W.	22	SE 1/4 of NW 1/4	11.5	June 5, 1948
11 S.	4 W.	22	SW 1/4 of NE 1/4	8.0	June 5, 1948
				49.0	

165-584

Beginning at the Southwest corner of William Moore D.L.C.#1790 Cl. #60 in T. 11 S., R 4 W. of the Will. Mer. in Linn Co. Ore.; running thence North on the West line of said Cl. 26.15 chains; thence East parallel with the North line of said 26.15 chains; more or less to the center of the county road; thence S. 1°40' W. 8.76 chains; thence S. 21°05' W. 5.70 chains thence S. 43°W. 12.96 chains; thence S. 58°40' W. 3 chains; thence S. 73°30' W. 6.17 chains to the South line of said claim; thence West 1.10 chains to the place of beginning containing 43.89 acres, more or less all being in Linn Co. Ore. Subject to Federal Land Bank Mtg. thereon.


202-324

Part of the William Moore D.L.C.#60 in T. 11 S., R 4 W. of the Will. Mer. and more particularly described as Beginning on the West line of said D.L.C. North 25 lks from the North line of Section 22 in said Township and Range; thence South along said West line to the spring leaf 1553.28 feet South of the Northwest corner of said D.L.C; thence East 885 feet; thence N. 1°23' E. 930.60 feet to a point 25 links North of the North line of said Sec. 22; thence West to the place of beginning.

Exception: Beginning at the Southwest corner of William Moore D.L.C.#60 in T. 11 S., R 4 W. of the Will. Mer. in Linn County, Oregon; and running thence N. 1°00' E. along the West line of said Claim 242.97 feet; thence N. 75°00' E. 497.14 feet to a 5/8" iron rod; thence S. 13°44' E. 231.37 feet to the centerline of a State Highway; thence S. 58°15' W. along said centerline 85.31 feet; thence S. 75°30' W. along said centerline 407.20 feet to the South line of Cl. #60; thence West 72.60 feet to the place of beginning and containing 3.057 acres, more or less all situated and lying in Linn County, Oregon.

ation for a permit, permit, certificate or adjudicated right to appropriate water made or held by the registrant.

Township 11 S Range 4 W W.M.
North

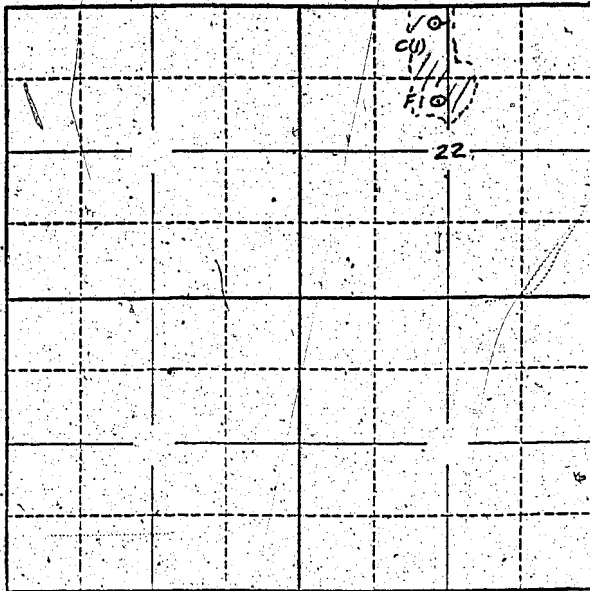

Locate well and acreage of irrigated land on plat.
Scale: 2" = 1 Mile

STATE OF OREGON

County of Linn } ss.

I, Philip W. and Elizabeth Haddan being first duly sworn, do hereby certify that I have read the foregoing Registration Statement and that all of the items therein contained are true to the best of my knowledge and belief.

Elizabeth E. Haddan

Philip W. Haddan
(Signature of Registrant)

Subscribed and sworn to before me this 29 day of February, 1956.

My commission expires June 13, 1958.

Alfred M. Benson
Notary Public for Oregon.
(Notary Public)

(SEAL)

CERTIFICATE OF REGISTRATION

STATE OF OREGON

County of Marion } ss.

This is to certify that the foregoing Registration Statement was received in the office of the State Engineer on the 8th day of March, 1956, at 8 o'clock A.M. and has been duly recorded in said office in Book No. 1 of Registration Statements on page GR-136 C.

~~Construction shall be completed by _____ and the water completely applied to beneficial use by _____~~

Witness my hand this 8th day of October, 1956.

Lewis A. Stanley
(State Engineer)

By _____
(Deputy)