

RECEIVED  
MAR 13 1956  
STATE ENGINEER  
SALEM, OREGON

REGISTRATION NO. GR-443  
CERTIFICATE NO. GR-137

### Registration Statement

#### OF CLAIMANT OF RIGHT TO APPROPRIATE GROUND WATER

(Under Chapter 708, Oregon Laws 1955.)

TO THE STATE ENGINEER OF OREGON:

I, George W. and Elsie Schwab

of Rt. 2, Box 293, Albany County of Linn

State of Oregon, do hereby make application for a certificate of registration as evidence of a right to appropriate ground water.

1. Source from which water is withdrawn is pump well  
(Flowing well, pump well, infiltration trench, or tunnel)

2. Location is: 5 miles North Albany, Oregon  
(Approximate distance and direction from nearest city or town)

and is more particularly described as follows:

(a) W. 18.60 chains from the SE corner of the Edmond C. McClain DLC #70  
(Give distance and bearing to corner of section or other legal subdivision)

being within SW $\frac{1}{4}$  of SE $\frac{1}{4}$  of Sec. 18, Twp. 10 S, Rge. 3 W  
(Smallest legal subdivision) (N. or S.) (E. or W.)

or (b) within limits of recorded platted property, town or city:

in Lot \_\_\_\_\_, Block \_\_\_\_\_ of \_\_\_\_\_  
(Name of plat or addition)

County of Linn  
(If within city or town, give name)

3. Construction Work was begun on Oct. 3, 1954; was completed on Oct. 5, 1954  
(Date) (Date)

and the ground water claimed was first used for the purposes set out below on June 18, 1955  
(Date)

since which time the water has been used continuously  
(Continuously or intermittently)

from June 18, 1955 to present time  
(Date) (Date)

4. Quantity of water claimed and used is 238 gallons per minute; 100.0 acre feet per year.

5. Purpose or Purposes for which water is used Irrigation

(Domestic, irrigation, municipal, manufacturing, industrial, etc.)

6. Description of Well: Depth 35 feet. Type drilled  
(Dug or drilled)

diameter 8 inches. Elevation of ground at well site 197 feet, mean sea level,  
(As near as known)

Depth to water table 6 feet.

7. Capacity of Well: 600 g.p.m. with 18 feet drawdown.

\_\_\_\_\_ g.p.m. with \_\_\_\_\_ feet drawdown.

Date of test Oct. 5, 1954

If Flowing Well: Measured discharge \_\_\_\_\_ g.p.m. on \_\_\_\_\_  
(Date)

Shut-in pressure at ground surface \_\_\_\_\_ lbs. per sq. in. on \_\_\_\_\_  
(Date)

Water is controlled by \_\_\_\_\_  
(Cap, valve, etc.)

8. Casing: (Give diameter, commercial specifications and depth below ground surface of each casing size.)

8 inch diameter steel casing from 0 to 35 feet  
 inch diameter from to feet  
 inch diameter from to feet  
 inch diameter from to feet

Describe and show depth of shoe, plug, adapter, liner or other details:

9. Perforated Casings or Screens:

Slit perforations from 25 to 35  
(Number per foot and size of perforations, or describe screen)  
 from to  
 from to  
 from to

10. Log of Well: (Describe each stratum or formation clearly, indicate if water bearing, and give thickness and depth as indicated.)

MATERIAL	Thickness (Feet)	Depth to Bottom (Feet)
Not available		

If log of well is not available, give name and address of driller. Nicholas Klaus, Rt. 4, Albany, Oregon

11. Infiltration Trench: Covered or open

Dimensions: Length \_\_\_\_\_ ft. Minimum depth \_\_\_\_\_ ft. Maximum depth \_\_\_\_\_ ft.

Bottom width \_\_\_\_\_ ft. Discharge \_\_\_\_\_ g.p.m. Date of test \_\_\_\_\_

12. Tunnel: Type of lining

Dimensions: \_\_\_\_\_  
(Length, course, and cross sectional size)

Position of water bearing stratum with reference to portal of tunnel \_\_\_\_\_

Log of tunnel: (Preceding table for log of well may be used, if desired. Give footage from portal and character of materials, as pertinent.)

13. Pumping Equipment:

(a) Pump Fairbanks Morse centrifugal 2<sup>nd</sup> discharge Capacity 250 g.p.m.  
(Make, type and size)

(b) Motor 10 H. P. electric  
(Type and horsepower)

14. Location of area irrigated or to be irrigated, or place of use if for purposes other than irrigation.

Township North or South	Range E. or W. of Willamette Meridian	Section	Forty-acre Tract	Number Acres To Be Irrigated	Date of Reclamation
10 S	3 W.	18	NE $\frac{1}{4}$ of SE $\frac{1}{4}$	0.7	June 18, 1955
10 S	3 W.	18	NW $\frac{1}{4}$ of SE $\frac{1}{4}$	0.1	June 18, 1955
10 S	3 W.	18	SW $\frac{1}{4}$ of SE $\frac{1}{4}$	5.2	June 18, 1955
10 S	3 W.	18	SE $\frac{1}{4}$ of SE $\frac{1}{4}$	34.0	June 18, 1955
				40.0	


George Schwab  
224-759

Beginning at the Southeast corner of the D.L.C. of E. C. McClain & wife Not. #1462 and Claim #70 in T. 10 S., R 3 W. of the Will. Mer. in Linn County, Oregon; and from thence running North along the East boundary line of said Claim 20.40 chains; thence West 19.60 chains; thence South parallel with the East boundary line of said Claim 20.40 chains to the South boundary line of said Claim; thence East 19.60 chains to the place of beginning.

RECORDED  
JUN 18 1955  
STATE ENGINEER  
SALEM, OREGON


15. If the ground water supply is supplemental to an existing water supply, identification of any application for a permit, permit, certificate or adjudicated right to appropriate water made or held by the registrant.

Township 10 S. Range 3 W. W.M.  
North

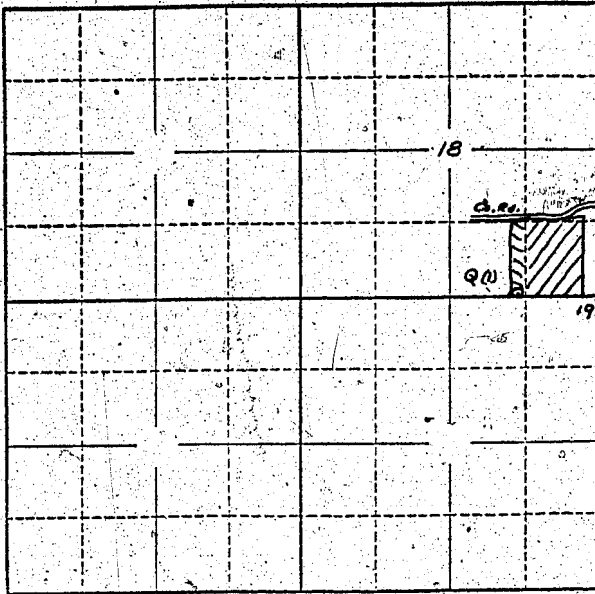

Locate well and acreage of irrigated land on plat.

Scale: 2" = 1 Mile

STATE OF OREGON

County of Linn

ss.

I, George W. and Elsie Schwab, being first duly sworn, do hereby certify that I have read the foregoing Registration Statement and that all of the items therein contained are true to the best of my knowledge and belief.

*Elsie M. Schwab*  
*George W. Schwab*  
(Signature of Registrant)

Subscribed and sworn to before me this 9th day of March, 1956

My commission expires

*W. M. ...*  
County Clerk  
(Notary Public)

(SEAL)

CERTIFICATE OF REGISTRATION

STATE OF OREGON

County of Marion

ss.

This is to certify that the foregoing Registration Statement was received in the office of the State Engineer on the 12th day of March, 1956, at 8 o'clock A.M. and has been duly recorded in said office in Book No. of Registration Statements on page GR-137 C.

~~Construction shall be completed by ... and the water completely applied to beneficial use by ...~~

Witness my hand this 8th day of October, 1956

*Lewis A. Stanley*  
(State Engineer)

By \_\_\_\_\_ (Deputy)