

# Registration Statement

## OF CLAIMANT OF RIGHT TO APPROPRIATE GROUND WATER

TO THE STATE ENGINEER OF OREGON:

I, Grenold Collins (Porterfield Farm)

of Route #1, Box 38, Independence County of Polk  
(Mailing address)

State of Oregon, do hereby make application for a certificate of registration as evidence of a right to appropriate ground water.

1. Source from which water is withdrawn is Flowing Well  
(Flowing well, pump well, infiltration trench, or tunnel)

2. Location is: About 5 miles south of Independence, Oregon  
(Approximate distance and direction from nearest city or town)

and is more particularly described as follows:

(a) 1300 ft S 12° 30' W from the NE corner  
of the Jno. Thorp DC (Give distance and bearing to corner of section or other legal subdivision)

being within NE 1/4 of S 1/4 of Sec. 11, Twp. 9 S, Rge. 4 W  
(Smallest legal subdivision) (N. or S.) (E. or W.)

or (b) within limits of recorded platted property, town or city: —

in Lot \_\_\_\_\_, Block \_\_\_\_\_ of \_\_\_\_\_  
(Name of plat or addition)

County of Polk  
(If within city or town, give name)

3. Construction Work was begun on 1942; was completed on 1942  
(Date) (Date)

and the ground water claimed was first used for the purposes set out below on 1942  
(Date)

since which time the water has been used Intermittently  
(Continuously or Intermittently)

from 1942 to 1957  
(Date) (Date)

4. Quantity of water claimed and used is 450 gallons per minute; unknown acre feet per year.

5. Purpose or Purposes for which water is used Irrigation of crops  
(Domestic, irrigation, municipal, manufacturing, industrial, etc.)

6. Description of Well: Depth 46 feet. Type Drilled Well  
(Dug or drilled)

diameter 10 inches. Elevation of ground at well site 105 feet, mean sea level.  
(As near as known)

Depth to water table 6 to 12 feet.

7. Capacity of Well: 450 g.p.m. with 6 feet drawdown.  
\_\_\_\_\_ g.p.m. with \_\_\_\_\_ feet drawdown.

Date of test 1954

If Flowing Well: Measured discharge \_\_\_\_\_ g.p.m. on \_\_\_\_\_  
(Date)

Shut-in pressure at ground surface \_\_\_\_\_ lbs. per sq. in. on \_\_\_\_\_  
(Date)

Water is controlled by \_\_\_\_\_  
(Cap, valve, etc.)

8. Casing: (Give diameter, commercial specifications and depth below ground surface of each casing size.)

..... 10 inch diameter ..... 38 feet ..... from ..... 8' ..... to ..... 46 ..... feet  
..... inch diameter ..... from ..... to ..... feet  
..... inch diameter ..... from ..... to ..... feet  
..... inch diameter ..... from ..... to ..... feet

Describe and show depth of shoe, plug, adapter, liner or other details: ..... Unknown .....  
.....  
.....

9. Perforated Casings or Screens:

..... Perforated ..... from 38 to 46 .....  
(Number per foot and size of perforations, or describe screen)  
..... from ..... to .....  
..... from ..... to .....  
..... from ..... to .....

10. Log of Well: (Describe each stratum or formation clearly, indicate if water bearing, and give thickness and depth as indicated.)

MATERIAL	Thickness (Feet)	Depth to Bottom (Feet)
<b>Strata unknown</b>		

If log of well is not available, give name and address of driller. ....

**Mr. Art Sloper, Deceased**

11. Infiltration Trench: Covered or open open

Dimensions: Length ..... ft. Minimum depth ..... ft. Maximum depth ..... ft.

Bottom width ..... ft. Discharge ..... g.p.m. Date of test .....

12. Tunnel: Type of lining .....

Dimensions: .....  
(Length, course, and cross sectional size)

Position of water bearing stratum with reference to portal of tunnel .....

Log of tunnel: (Preceding table for log of well may be used, if desired. Give footage from portal and character of materials, as pertinent.)

13. Pumping Equipment: Portable pumps

(a) Pump Various, None installed at present Capacity ..... g.p.m.  
(Make, type and size)

(b) Motor .....  
(Type and horsepower)


14. Location of area irrigated or to be irrigated, or place of use if for purposes other than irrigation.

Township North or South	Range E. or W. of Willamette Meridian	Section	Forty-acre Tract	Number Acres To Be Irrigated	Date of Reclamation
95	4W	11	SW <sup>1</sup> / <sub>4</sub> of NW <sup>1</sup> / <sub>4</sub> of SW <sup>1</sup> / <sub>4</sub>	2 <sup>2</sup>	1942
95	4W	11	SE <sup>1</sup> / <sub>4</sub> of NW <sup>1</sup> / <sub>4</sub>	14 <sup>6</sup>	1942
95	4W	11	NW <sup>1</sup> / <sub>4</sub> of SE <sup>1</sup> / <sub>4</sub>	2 <sup>0</sup>	1942
95	4W	11	NE <sup>1</sup> / <sub>4</sub> of SW <sup>1</sup> / <sub>4</sub>	17 <sup>2</sup>	1942
				<u>37.1</u>	

15. If the ground water supply is supplemental to an existing water supply, identification of any application for a permit, permit, certificate or adjudicated right to appropriate water made or held by the registrant.

Township 9S Range 4W W.M.  
North

See map on  
separate sheet

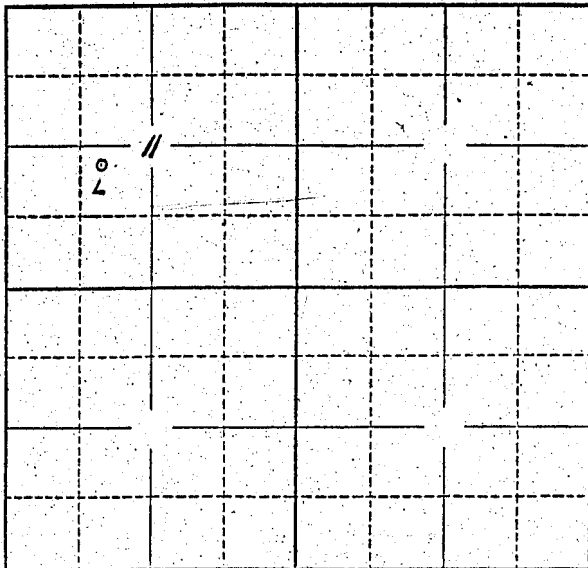

Locate well and acreage of irrigated land on plat.

Scale: 2" = 1 Mile

STATE OF OREGON

County of Polk

} ss.

I, Grenold Collins, being first duly sworn, do hereby certify that I have read the foregoing Registration Statement and that all of the items therein contained are true to the best of my knowledge and belief.

Grenold Collins  
(Signature of Registrant)

Subscribed and sworn to before me this 15th day of April, 1954.

My commission expires Sept. 10, 1960

Estelade Carter  
(Notary Public)

(SEAL)

**CERTIFICATE OF REGISTRATION**

STATE OF OREGON

County of Marion

} ss.

This is to certify that the foregoing Registration Statement was received in the office of the State Engineer on the 17th day of April, 1954, at 5:00 o'clock A. M. and has been duly recorded in said office in Book No. 7 of Registration Statements on page GR-1288

Witness my hand this 20th day of October, 1958.

Lewis A. Stanley  
(State Engineer)

By \_\_\_\_\_  
(Deputy)