

Registration Statement

REGISTRATION NO. GR-1436CERTIFICATE NO. GR-1390

OF CLAIMANT OF RIGHT TO APPROPRIATE GROUND WATER

(Under Chapter 708, Oregon Laws 1955.)

TO THE STATE ENGINEER OF OREGON:

I, Archie Ernest Felkerof 3215 River Bend Rd. County of PolkState of Oregon, do hereby make application for a certificate of registration as evidence of a right to appropriate ground water.1. Source from which water is withdrawn is Pump Well

(Flowing well, pump well, infiltration trench, or tunnel)

2. Location is: 4 miles north of Salem

(Approximate distance and direction from nearest city or town)

and is more particularly described as follows:

(a) 740' N. and 1140' W. of S.E. Corner of S.E. 1/4 N.E. 1/4

(Give distance and bearing to corner of section or other legal subdivision)

being within S.E. 1/4 N.E. 1/4

(Smallest legal subdivision)

of Sec. 9Twp. 7 S.Rge. 3 W.

(N. or S.)

(E. or W.)

or (b) within limits of recorded platted property, town or city:

in Lot _____, Block _____ of _____

(Name of plat or addition)

County of _____

(If within city or town, give name)

3. Construction Work was begun on 2-21-53

(Date)

; was completed on 2-25-53

(Date)

and the ground water claimed was first used for the purposes set out below on March 1953

(Date)

since which time the water has been used Intermittently

(Continuously or intermittently)

from Feb. 25, 1953 to Feb. 20, 1958

(Date)

(Date)

4. Quantity of water claimed and used is 800 gallons per minute; 280 acre feet per year.5. Purpose or Purposes for which water is used Irrigation

(Domestic, irrigation, municipal, manufacturing, industrial, etc.)

6. Description of Well: Depth 74' 6" feet. Type Drilled

(Dug or drilled)

diameter 10" 1-D inches. Elevation of ground at well site Not Known feet, mean sea level.

(As near as known)

Depth to water table 13' feet.7. Capacity of Well: 500 g.p.m. with 2 feet drawdown.

_____ g.p.m. with _____ feet drawdown.

Date of test 2-25-53

If Flowing Well: Measured discharge _____ g.p.m. on _____

(Date)


Shut-in pressure at ground surface _____ lbs. per sq. in. on _____

(Date)

Water is controlled by _____

(Cap, valve, etc.)

Township 7S Range 3W, W.M.
North

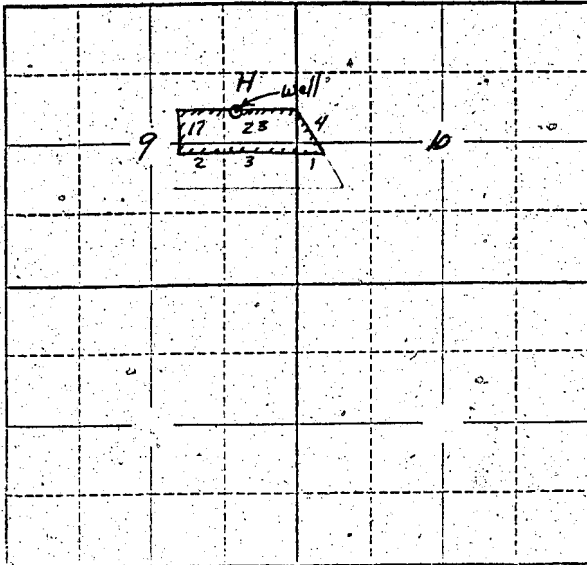

Locate well and acreage of irrigated land on plat.
Scale: 2" = 1 Mile

STATE OF OREGON

County of Marion ss.

I, Archie E. Pelton, being first duly sworn, do hereby certify that I have read the foregoing Registration Statement and that all of the items therein contained are true to the best of my knowledge and belief.

Archie E. Pelton
(Signature of Registrant)

Subscribed and sworn to before me this 17th day of April, 1958

My commission expires 12th June 1961 Wm. S. Bartholomew
(Notary Public)

(SEAL)

CERTIFICATE OF REGISTRATION

STATE OF OREGON

County of Marion ss.

This is to certify that the foregoing Registration Statement was received in the office of the State Engineer on the 17th day of April, 1958, at 2:15 o'clock P. M. and has been duly recorded in said office in Book No. 7 of Registration Statements on page 6K-1390

~~and the same is hereby certified to be correct and true to the best of my knowledge and belief.~~

Witness my hand this 20th day of October, 1958

Lewis A. Stanley
(State Engineer)

By _____ (Deputy)

6K-1390