Registration No. GR 1138

Certificate No. GR 1584

Registration Statement

OF CLAIMANT OF RIGHT TO APPROPRIATE GROUND WATER

TO THE STATE ENGINEER OF OREGON:

I, FAIRVIEW FARMS INC,

of Rte Box 40 TROUTDALE (Mailing address) County of MULT.

State of OREGON, do hereby make application for a certificate of registration as evidence of a right to appropriate ground water.

1. **Source** from which water is withdrawn is PUMP WELL #1 (Flowing well, pump well, infiltration trench, or tunnel)

2. **Location** is: 1 MILE WEST OF TROUTDALE (Approximate distance and direction from nearest city or town);

and is more particularly described as follows:

(a) 2740' SOUTH OF CORNER OF SECTION 22-23-26-27 (Give distance and bearing to corner of section or other legal subdivision)

being within SE¼ of NE¼ (Smallest legal subdivision) of Sec. 27, Twp. 1N (N. or S.), Rge. 3E (E. or W.)

or (b) within limits of recorded platted property, town or city:

in Lot ....., Block ..... of ..... (Name of plat or addition)

..... (If within city or town, give name) County of Multnomah

3. **Construction Work** was begun on Nov 1954 (Date); was completed on DEC 1954 (Date)

and the ground water claimed was first used for the purposes set out below on 1954 (Date),

since which time the water has been used PUMP TO BE INSTALLED (Continuously or intermittently)

from 1954 (Date) to 1957 (Date)

4. **Quantity** of water claimed and used is 110 gallons per minute; ..... acre feet per year.

5. **Purpose or Purposes** for which water is used

DOMESTIC & IRRIGATION & MANUFACTURING (Domestic, irrigation, municipal, manufacturing, industrial, etc.)

6. **Description of Well:** Depth 182 feet. Type DRILLED (Dug or drilled)

diameter 8" inches. Elevation of ground at well site 65 (As near as known) feet, mean sea level.

Depth to water table ..... feet.

7. **Capacity of Well:** 110 g.p.m. with 75 feet drawdown.

..... g.p.m. with ..... feet drawdown.

Date of test .....

If Flowing Well: Measured discharge ..... g.p.m. on ..... (Date)

Shut-in pressure at ground surface ..... lbs. per sq. in. on ..... (Date)

Water is controlled by ..... (Cap, valve, etc.)

4M—4-57

8. **Casing:** (Give diameter, commercial specifications and depth below ground surface of each casing size.)

8 inch diameter from SURFACE to 162 feet

inch diameter from to feet

inch diameter from to feet

inch diameter from to feet

Describe and show depth of shoe, plug, adapter, liner or other details:

9. **Perforated Casings or Screens:**

PERFORATED from 139' to 143'
(Number per foot and size of perforations, or describe screen)

PERFORATED from 143' to 150'

from to

from to

10. **Log of Well:** (Describe each stratum or formation clearly, indicate if water bearing, and give thickness and depth as indicated.)

MATERIAL	Thickness (Feet)	Depth to Bottom (Feet)
TOP SOIL	SURFACE	6'
YELLOW CLAY	6'	14'
YELLOW CLAY + BOULDERS	14'	29'
BLUE CLAY SAND & SILT	29'	137'
GRAVEL NOT GOOD WATER GRAVEL	137'	150'
GRAVEL WITH BINDER	150'	160'
BROWN CLAY	160'	164'
CEMENTED GRAVEL	164'	162'

GR 1584

If log of well is not available, give name and address of driller. .....

11. **Infiltration Trench:** Covered or open .....

Dimensions: Length ..... ft. Minimum depth ..... ft. Maximum depth ..... ft.

Bottom width ..... ft. Discharge ..... g.p.m. Date of test .....

12. **Tunnel:** Type of lining .....

Dimensions: .....
(Length, course, and cross sectional size)

Position of water bearing stratum with reference to portal of tunnel .....

Log of tunnel: (Preceding table for log of well may be used, if desired. Give footage from portal and character of materials, as pertinent.)

13. **Pumping Equipment:** TO BE INSTALLED

(a) Pump PEERLESS TURBINE (Make, type and size) Capacity 100 g.p.m.

(b) Motor 10 HP (Type and horsepower)

14. Location of area irrigated or to be irrigated, or place of use if for purposes other than irrigation.

Township North or South	Range E. or W. of Willamette Meridian	Section	Forty-acre Tract	Number Acres To Be Irrigated	Date of Reclamation
1N	3E	27	SW¼ of NE¼	2	
1N	3E	27	NW¼ of SE¼	2	
1N	3E	27	SE¼ of NE¼	3	
1N	3E	27	NE¼ of SE¼	3	
				10	
1N	3E	27	SE¼ of NE¼	7	1954
1N	3E	27	NE¼ of SE¼	7	"
1N	3E	[illegible]	SE¼ of NE¼	2	"

15. If the ground water supply is supplemental to an existing water supply, identification of any application for a permit, permit, certificate or adjudicated right to appropriate water made or held by the registrant.

.....

.....

Township 1N Range 3E, W.M.

North

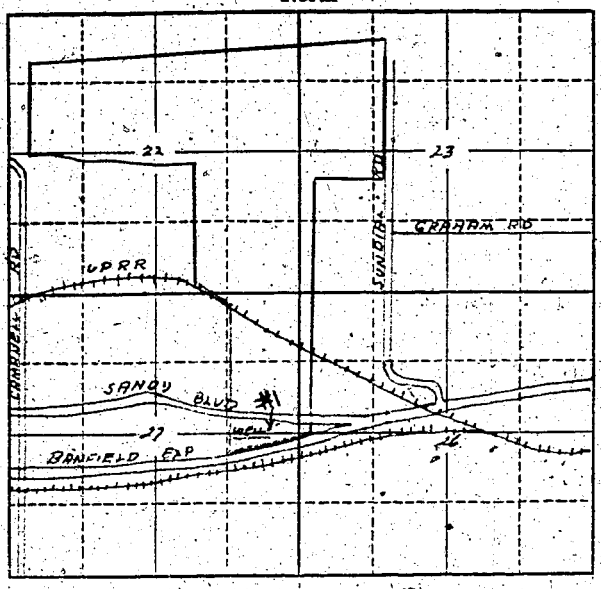

Locate well and acreage of irrigated land on plat.

Scale: 2" = 1 Mile

STATE OF OREGON
County of Multnomah } ss.

I, Sophie George, being first duly sworn, do hereby certify that I have read the foregoing Registration Statement and that all of the items therein contained are true to the best of my knowledge and belief.

Fairview Farms, Inc.
Secretary
(Signature of Registrant)

Subscribed and sworn to before me this 21st day of March, 1958.

My commission expires 3-7-62
(Notary Public)

(SEAL)

CERTIFICATE OF REGISTRATION

STATE OF OREGON
County of Marion } ss.

This is to certify that the foregoing Registration Statement was received in the office of the State Engineer on the 18th day of April, 1958, at 4:00 o'clock P M. and has been duly recorded in said office in Book No. 7 of Registration Statements on page GR-1584

Witness my hand this 1st day of December, 1958

Lewis A. Stanley
(State Engineer)

$25.00

By
(Deputy)

GR - 1584