

Registration Statement

OF CLAIMANT OF RIGHT TO APPROPRIATE GROUND WATER
(Under Chapter 708, Oregon Laws 1955.)

TO THE STATE ENGINEER OF OREGON:

I, TOWN OF STAYTON

of CITY HALL County of MARIAN

State of OREGON, do hereby make application for a certificate of registration as evidence of a right to appropriate ground water.

1. Source from which water is withdrawn is INFILTRATION TRENCH
(Flowing well, pump well, infiltration trench, or pond)

2. Location is: INSIDE THE PRESENT CITY LIMITS OF STAYTON
(Approximate distance and direction from nearest city or town)

and is more particularly described as follows:

(a) EAST 576.25 x 116.25 FT. - South of Sec. Cor. 1st Line
(Give distance and bearing to corner of section or other legal subdivision)

being within N.W. 1/4, S.E. 1/4 of Sec. 15, Twp. 9 S, Rge. 1 W
(Smallest legal subdivision) (N. or S.) (E. or W.)

or (b) within limits of recorded platted property, town or city:

in Lot _____, Block _____ of MEETS & BOUNDS
(Name of plat or addition)

TOWN OF STAYTON County of MARIAN
(If within city or town, give name)

3. Construction Work was begun on 25 January 1930; was completed on EXTENSION EVERY YEAR To 1955
(Date) (Date)

and the ground water claimed was first used for the purposes set out below on 25 YEARS AGO (1930)
(Date)

since which time the water has been used CONTINUOUSLY
(Continuously or intermittently)

from 1930 to PRESENT TIME
(Date) (Date)

4. Quantity of water claimed and used is 1200 gallons per minute; _____ acre feet per year.

5. Purpose or Purposes for which water is used PUBLIC MUNICIPAL WATER SUPPLY FOR THE CITY OF STAYTON
(Domestic, irrigation, municipal, manufacturing, industrial, etc.)

6. Description of Well: Depth 2.5 feet. Type DUG
(Dug or drilled)

diameter 18" inches. Elevation of ground at well site _____ feet, mean sea level.
(As near as known)

Depth to water table 5' feet.

7. Capacity of Well: 1000 g.p.m. with 10 feet drawdown.
_____ g.p.m. with _____ feet drawdown.

Date of test August 1955

If Flowing Well: Measured discharge --- g.p.m. on _____
(Date)

Shut-in pressure at ground surface _____ lbs. per sq. in. on _____
(Date)

Water is controlled by _____
(Cap, valve, etc.)

8. **Casing:** (Give diameter, commercial specifications and depth below ground surface of each casing size.)

40' inch diameter CONCRETE from 0 to 25' feet
 inch diameter from to feet
 inch diameter from to feet
 inch diameter from to feet

Describe and show depth of shoe, plug, adapter, liner or other details: AT 18' 3" INfiltration
LANE PLUG AT BOTTOM 25' DOWN

9. **Perforated Casings or Screens:**

1/4" - 3 inches apart from 15' to 25'
(Number per foot and size of perforations, or describe screen)
 from to
 from to
 from to

10. **Log of Well:** (Describe each stratum or formation clearly, indicate if water bearing, and give thickness and depth as indicated.)

MATERIAL	Thickness (Feet)	Depth to Bottom (Feet)
<i>No log available - machine deep many years ago</i>		

If log of well is not available, give name and address of driller. Not known

11. Infiltration Trench: Covered or open COVERED

Dimensions: Length 50 ft. Minimum depth 18 ft. Maximum depth 18 ft.

Bottom width 21" PIP. Discharge 1000 g.p.m. Date of test August 1955

12. Tunnel: Type of lining

Dimensions: _____
(Length, course, and cross sectional size)

Position of water bearing stratum with reference to portal of tunnel

Log of tunnel: (Preceding table for log of well may be used, if desired. Give footage from portal and character of materials, as pertinent.)

13. Pumping Equipment:

(a) Pump HYDRAULIC TURBINE 4 S stage TURBINE Capacity 1000 g.p.m.
(Make, type and size)


(b) Motor 40 HORSEPOWER ELECTRIC & HYDROLIC
(Type and horsepower)

14. Location of area irrigated or to be irrigated, or place of use if for purposes other than irrigation.

Township North or South	Range E. or W. of Willamette Meridian	Section	Forty-acre Tract	Number Acres To Be Irrigated	Date of Reclamation
9S	1W	10	NE 1/4 OF SW 1/4 NW 1/4 OF SW 1/4 SE 1/4 OF NW 1/4		1930
9S	1W	10	SW 1/4 OF NW 1/4		
9S	1W	9	NE 1/4 OF SE 1/4 SE 1/4 OF SE 1/4		
9S	1W	10	SE 1/4 OF NE 1/4 SW 1/4 OF NE 1/4		
9S	1W	10	SE 1/4 OF SW 1/4 SW 1/4 OF SW 1/4		
9S	1W	10	NE 1/4 OF SE 1/4		
9S	1W	10	NW 1/4 OF SE 1/4		
9S	1W	10	SE 1/4 OF SE 1/4		
9S	1W	10	SW 1/4 OF SE 1/4		

15. If the ground water supply is supplemental to an existing water supply, identification of any application for a permit, permit, certificate or adjudicated right to appropriate water made or held by the registrant.

Township 9 S Range 1 W W.M.
North

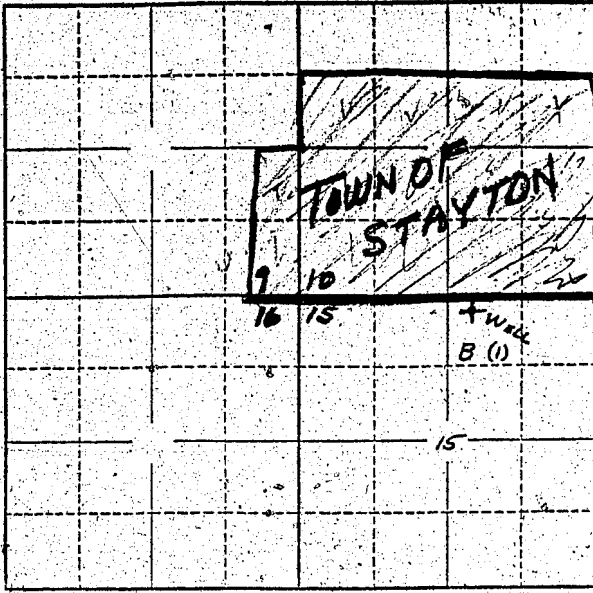

Locate well and acreage of irrigated land on plat.

Scale: 2" = 1 Mile

STATE OF OREGON

County of _____ } ss.

I, M. Van Driessle, being first duly sworn, do hereby certify that I have read the foregoing Registration Statement and that all of the items therein contained are true to the best of my knowledge and belief.

M. Van Driessle
(Signature of Registrant)

Subscribed and sworn to before me this 16 day of March, 1956.

My commission expires Sept. 9, 1956
Chas. J. [Signature]
(Notary Public)

(SEAL)

CERTIFICATE OF REGISTRATION

STATE OF OREGON }
County of Marion } ss.

This is to certify that the foregoing Registration Statement was received in the office of the State Engineer on the 16th day of March, 1956, at 1:30 o'clock P.M. and has been duly recorded in said office in Book No. 1 of Registration Statements on page GR-139 C.

~~Construction shall be completed by _____ 19____ and the water completely supplied to _____ 19____~~

Witness my hand this 8th day of October, 1956

Lewis A. Stanley
(State Engineer)

By _____
(Deputy)