

Registration Statement

REGISTRATION NO. GR 1455CERTIFICATE NO. GR-1404

OF CLAIMANT OF RIGHT TO APPROPRIATE GROUND WATER

(Under Chapter 708, Oregon Laws 1955.)

TO THE STATE ENGINEER OF OREGON:

I, Adrian A. Withers or Pearl F. Withers
 of R1 Box 868 Salem County of Marion

State of Ore, do hereby make application for a certificate of registration as evidence of a right to appropriate ground water.

1. Source from which water is withdrawn is Jump Well
(Flowing well, pump well, infiltration trench, or tunnel)

2. Location is: Seven miles South West of Salem R.3 Box 732
(Approximate distance and direction from nearest city or town)

and is more particularly described as follows:

(a) 580 ft North and 100 ft West of South East corner of Section 18
(Give distance and bearing to corner of section or other legal subdivision)

being within SE 1/4 SE 1/4 of Sec. 18, Twp. 9 S, Rge. 3 W
(Smallest legal subdivision) (N. or S.) (E. or W.)

or (b) within limits of recorded platted property, town or city:

in Lot _____, Block _____ of _____
(Name of plat or addition)

County of _____
(If within city or town, give name)

3. Construction Work was begun on Oct 5 1954; was completed on Oct 13 1954
(Date) (Date)

and the ground water claimed was first used for the purposes set out below on June 1953
(Date)

since which time the water has been used at times that irrigation is needed
(Continuously or intermittently)

from May to October
(Date) (Date)

4. Quantity of water claimed and used is 150 gallons per minute; 90 acre feet per year.

5. Purpose or Purposes for which water is used Irrigation

(Domestic, irrigation, municipal, manufacturing, industrial, etc.)

6. Description of Well: Depth 77 feet. Type Drilled
(Dug or drilled)

diameter 12 inches. Elevation of ground at well site 702 feet, mean sea level.
(As near as known)

Depth to water table 10 feet.

7. Capacity of Well: 160 g.p.m. with 30 feet drawdown.

180 g.p.m. with 40 feet drawdown.

Date of test Oct 26 1954

If Flowing Well: Measured discharge _____ g.p.m. on _____
(Date)

Shut-in pressure at ground surface _____ lbs. per sq. in. on _____
(Date)

Water is controlled by _____
(Cap, valve, etc.)

8. Casing: (Give diameter, commercial specifications and depth below ground surface of each casing size.)

8 inch diameter from Top to 74 feet.
inch diameter from to feet
inch diameter from to feet
inch diameter from to feet

Describe and show depth of shoe, plug, adapter, liner or other details:

12 in Hole Gravel jacket to solid rock at 60 ft

9. Perforated Casings or Screens:

Two 2 1/2 feet wide 6 in long
(Number per foot and size of perforations, or describe screen) from 20 ft of Top to 10 ft of B
..... from to
..... from to
..... from to

10. Log of Well: (Describe each stratum or formation clearly, indicate if water bearing, and give thickness and depth as indicated.)

MATERIAL	Thickness (Feet)	Depth to Bottom (Feet)
Top 20 Clay 40ft Gravelly 17 ft Solid rock		74
	15	

If log of well is not available, give name and address of driller.

11. Infiltration Trench: Covered or open
 Dimensions: Length ft. Minimum depth ft. Maximum depth ft.

Bottom width ft. Discharge g.p.m. Date of test

12. Tunnel: Type of lining

Dimensions:
 (Length, course, and cross sectional size)

Position of water bearing stratum with reference to portal of tunnel

Log of tunnel: (Preceding table for log of well may be used, if desired. Give footage from portal and character of materials, as pertinent.)

13. Pumping Equipment:

(a) Pump *Berkley Turbine* Capacity *1500* g.p.m.
 (Make, type and size)

(b) Motor *10 horsepower electric*
 (Type and horsepower)


14. Location of area irrigated or to be irrigated, or place of use if for purposes other than irrigation.

Township North or South	Range E. or W. of Willamette Meridian	Section	Forty-acre Tract	Number Acres To Be Irrigated	Date of Reclamation
8S	3W	18	SE $\frac{1}{4}$ SE $\frac{1}{4}$	23.24	June 1955
8S	3W	17	SW $\frac{1}{4}$ SW $\frac{1}{4}$	11.07	" "
8S	3W	17	NW $\frac{1}{4}$ SW $\frac{1}{4}$	3.60	" "
			Total	37.91	

15. If the ground water supply is supplemental to an existing water supply, identification of any application for a permit, permit, certificate or adjudicated right to appropriate water made or held by the registrant.

Township 85 Range 3W W.M.

North

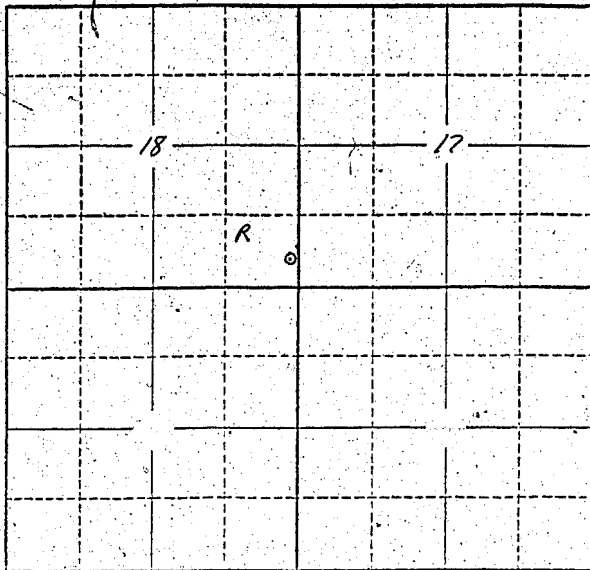

Locate well and acreage of irrigated land on plat.

Scale: 2" = 1 Mile

STATE OF OREGON

County of Marion } ss.

I, Adrian B. Withers, being first duly sworn, do hereby certify that I have read the foregoing Registration Statement and that all of the items therein contained are true to the best of my knowledge and belief.

Adrian B. Withers

(Signature of Registrant)

Subscribed and sworn to before me this 11 day of April, 1958

My commission expires 1/1/59

(Notary Public)

(SEAL)

CERTIFICATE OF REGISTRATION

STATE OF OREGON

County of Marion } ss.

This is to certify that the foregoing Registration Statement was received in the office of the State Engineer on the 21st day of April, 1958, at 10³⁰ o'clock A. M. and has been duly recorded in said office in Book No. 7 of Registration Statements on page GR-1404

~~Construction shall be completed by 10/20/58 and the water completely applied for beneficial use by 10/20/58~~

Witness my hand this 20th day of October, 1958

Lewis A. Stanley

(State Engineer)

By _____

(Deputy)

GR-1404