

# Registration Statement

## OF CLAIMANT OF RIGHT TO APPROPRIATE GROUND WATER

### TO THE STATE ENGINEER OF OREGON:

I, Wayne Major

of P. O. Box 447, Jacksonville, County of Jackson  
(Mailing address)

State of Oregon, do hereby make application for a certificate of registration as evidence of a right to appropriate ground water.

1. Source from which water is withdrawn is sump (infiltration trench)  
(Flowing well, pump well, infiltration trench, or tunnel)

2. Location is: Just outside city limits of Jacksonville (East)  
(Approximate distance and direction from nearest city or town)

and is more particularly described as follows:

(a) 1077 feet South and 1616 feet East from the NW corner DLC #90  
(Give distance and bearing to corner of section or other legal subdivision)

being within SE $\frac{1}{4}$  SE $\frac{1}{4}$  SE $\frac{1}{4}$  of Sec. 29, Twp. 37 S., Rge. 2 W.  
(Smallest legal subdivision) (N. or S.) (E. or W.)

or (b) within limits of recorded platted property, town or city:

in Lot \_\_\_\_\_, Block \_\_\_\_\_ of \_\_\_\_\_  
(Name of plat or addition)

County of \_\_\_\_\_  
(If within city or town, give name)

3. Construction Work was begun on August 1954; was completed on August 1954  
(Date) (Date)

and the ground water claimed was first used for the purposes set out below on April 1955  
(Date)

since which time the water has been used intermittently  
(Continuously or Intermittently)

from April 1955 to September 1957  
(Date) (Date)

4. Quantity of water claimed and used is 50 gallons per minute; 18 acre feet per year.

5. Purpose or Purposes for which water is used irrigation

(Domestic, irrigation, municipal, manufacturing, industrial, etc.)

6. Description of Well: Depth 12 feet. Type dug  
(Dug or drilled)

See Item 11

diameter 35" x 15". Elevation of ground at well site 1190 feet, mean sea level.  
(As near as known)

Depth to water table 6 feet.

7. Capacity of Well: 100 g.p.m. with 1 ft. drawdown.

\_\_\_\_\_ g.p.m. with \_\_\_\_\_ feet drawdown.

Date of test April 1955

If Flowing Well: Measured discharge \_\_\_\_\_ g.p.m. on \_\_\_\_\_  
(Date)

Shut-in pressure at ground surface \_\_\_\_\_ lbs. per sq. in. on \_\_\_\_\_  
(Date)

Water is controlled by \_\_\_\_\_  
(Cap, valve, etc.)

8. Casing: (Give diameter, commercial specifications and depth below ground surface of each casing size.)

inch diameter none from \_\_\_\_\_ to \_\_\_\_\_ feet  
 inch diameter \_\_\_\_\_ from \_\_\_\_\_ to \_\_\_\_\_ feet  
 inch diameter \_\_\_\_\_ from \_\_\_\_\_ to \_\_\_\_\_ feet  
 inch diameter \_\_\_\_\_ from \_\_\_\_\_ to \_\_\_\_\_ feet

Describe and show depth of shoe, plug, adapter, liner or other details: \_\_\_\_\_  
 \_\_\_\_\_  
 \_\_\_\_\_

9. Perforated Casings or Screens:

none from \_\_\_\_\_ to \_\_\_\_\_  
(Number per foot and size of perforations, or describe screen)  
 \_\_\_\_\_ from \_\_\_\_\_ to \_\_\_\_\_  
 \_\_\_\_\_ from \_\_\_\_\_ to \_\_\_\_\_  
 \_\_\_\_\_ from \_\_\_\_\_ to \_\_\_\_\_

10. Log of Well: (Describe each stratum or formation clearly, indicate if water bearing, and give thickness and depth as indicated.)

MATERIAL	Thickness (Feet)	Depth to Bottom (Feet)
Top soil not water bearing	8 ft.	4 ft.
Clay, some sandy, water bearing	4 ft.	0

If log of well is not available, give name and address of driller. ....

11. Infiltration Trench: Covered or open open .....

Dimensions: Length 35 ft. Minimum depth 10 ft. Maximum depth 12 ft.

Bottom width 10 ft. Discharge 50 g.p.m. Date of test April 1955 .....

12. Tunnel: Type of lining .....

Dimensions: .....  
(Length, course, and cross sectional size)

Position of water bearing stratum with reference to portal of tunnel .....

Log of tunnel: (Preceding table for log of well may be used, if desired. Give footage from portal and character of materials, as pertinent.)

13. Pumping Equipment:

(a) Pump Pacific, centrifugal, 2" Int. 1 1/2" Dis Capacity 100 g.p.m.  
(Make, type and size)


(b) Motor Electric 5 H.P. motor  
(Type and horsepower)

14. Location of area irrigated or to be irrigated, or place of use if for purposes other than irrigation.

Township North or South	Range E. or W. of Willamette Meridian	Section	Forty-acre Tract	Number Acres To Be Irrigated	Date of Reclamation
<u>37 S.</u>	<u>2 W.</u>	<u>28</u>	<u>W 1/2 SW 1/4 SW 1/4</u>	<u>2.2</u>	<u>Apr. 1955</u>
<u>"</u>	<u>"</u>	<u>29</u>	<u>E 1/2 SE 1/4 SE 1/4</u>	<u>1.8</u>	<u>Apr. 1955</u>
				<u>4.0</u>	

15. If the ground water supply is supplemental to an existing water supply, identification of any application for a permit, permit, certificate or adjudicated right to appropriate water made or held by the registrant.  
none

Township 37 S Range 2 W, W.M.  
North

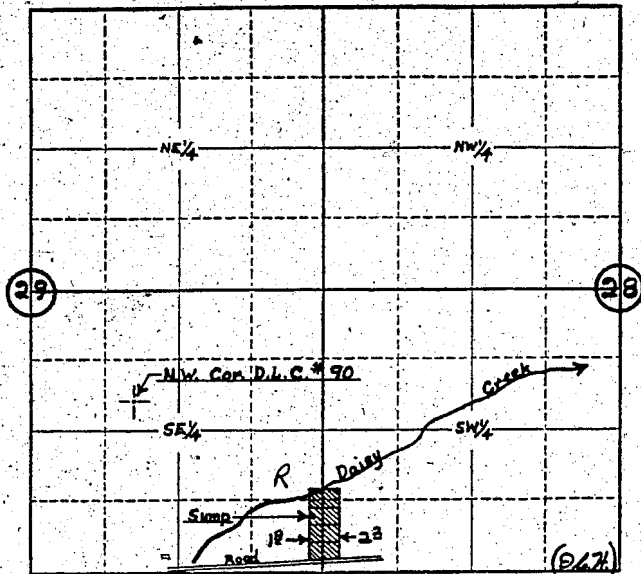

Locate well and acreage of irrigated land on plat.

Scale: 4" = 1 Mile

STATE OF OREGON

County of Jackson } ss.

I, Wm. Major, being first duly sworn, do hereby certify that I have read the foregoing Registration Statement and that all of the items therein contained are true to the best of my knowledge and belief.

Wm. Major  
(Signature of Registrant)

Subscribed and sworn to before me this 24th day of April, 1958

My commission expires August 25, 1958 Highland  
(Notary Public)

(SEAL)

**CERTIFICATE OF REGISTRATION**

STATE OF OREGON

County of Marion } ss.

This is to certify that the foregoing Registration Statement was received in the office of the State Engineer on the 21st day of April, 1958, at 5:00 o'clock A. M. and has been duly recorded in said office in Book No. 7 of Registration Statements on page GR-1405.

Witness my hand this 20th day of October, 1958

Lewis A. Stanley  
(State Engineer)

By \_\_\_\_\_ (Deputy)

GR - 1405