

RECEIVED  
APR 21 1958  
STATE ENGINEER  
SALEM, OREGON

# Registration Statement

REGISTRATION NO. GR-1460  
CERTIFICATE NO. GR-1409

## OF CLAIMANT OF RIGHT TO APPROPRIATE GROUND WATER

(Under Chapter 708, Oregon Laws 1955.)

TO THE STATE ENGINEER OF OREGON:

I, C. D. Walker & H. W. Shapiro  
Beaverton R 2 County of Wash

State of Or, do hereby make application for a certificate of registration as evidence of a right to appropriate ground water.

1. Source from which water is withdrawn is Pump Well #1  
(Flowing well, pump well, infiltration trench, or tunnel)

2. Location is: 1 1/4 miles south from Beaverton, Oregon  
(Approximate distance and direction from nearest city or town)

and is more particularly described as follows:

(a) S. 63° 0' E. 133.5 feet from N 1/4 Corner section 23  
(Give distance and bearing to corner of section or other legal subdivision)

being within 11W 1/4 of NE 1/4 of Sec. 23, Twp. 1 S, Rge. 2 W  
(Smallest legal subdivision) (N. or S.) (E. or W.)

or (b) within limits of recorded platted property, town or city:

in Lot \_\_\_\_\_, Block \_\_\_\_\_ of \_\_\_\_\_  
(Name of plat or addition)

County of W  
(If within city or town, give name)

3. Construction Work was begun on 10-5-51; was completed on 10-11-51  
(Date) (Date)

and the ground water claimed was first used for the purposes set out below on May 1952  
(Date)

since which time the water has been used continuously during season  
(Continuously or intermittently)

from May 1952 to Oct 1957  
(Date) (Date)

4. Quantity of water claimed and used is 35 gallons per minute; 12 acre feet per year.

5. Purpose or Purposes for which water is used Irrigation

(Domestic, irrigation, municipal, manufacturing, industrial, etc.)

6. Description of Well: Depth 179 feet. Type Drilled  
(Dug or drilled)

diameter 8 inches. Elevation of ground at well site \_\_\_\_\_ feet, mean sea level.  
(As near as known)

Depth to water table 50 feet.

7. Capacity of Well: 30 g.p.m. with 145 feet drawdown.

\_\_\_\_\_ g.p.m. with \_\_\_\_\_ feet drawdown.

Date of test 10-11-51

If Flowing Well: Measured discharge \_\_\_\_\_ g.p.m. on \_\_\_\_\_  
(Date)


Shut-in pressure at ground surface \_\_\_\_\_ lbs. per sq. in. on \_\_\_\_\_  
(Date)

Water is controlled by \_\_\_\_\_  
(Cap, valve, etc.)





Township 15 Range 24, W.M.  
North

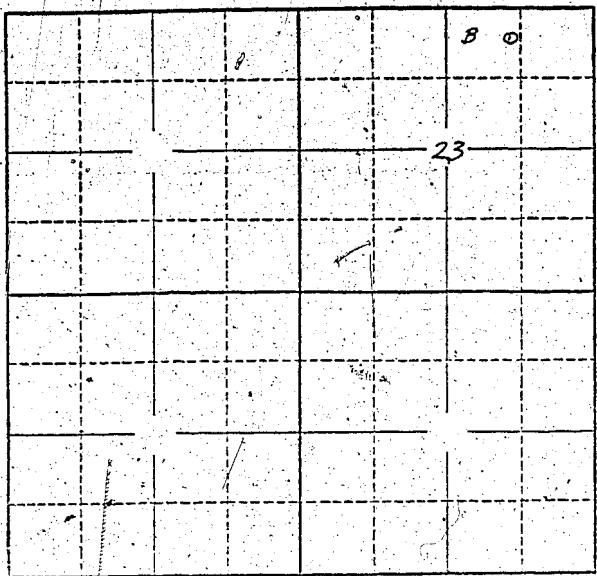

Locate well and acreage of irrigated land on plat.  
Scale: 2" = 1 Mile

STATE OF OREGON

County of Marion } ss.

I, C. D. Walker, being first duly sworn, do hereby certify that I have read the foregoing Registration Statement and that all of the items therein contained are true to the best of my knowledge and belief.

C. D. Walker  
(Signature of Registrant)

Subscribed and sworn to before me this 24th day of March, 1958

My commission expires 12th June 1961 Wm. S. Brathorne  
(Notary Public)

(SEAL)

**CERTIFICATE OF REGISTRATION**

STATE OF OREGON

County of Marion } ss.

This is to certify that the foregoing Registration Statement was received in the office of the State Engineer on the 21st day of April, 1958, at 2:30 o'clock A. M. and has been duly recorded in said office in Book No. 7 of Registration Statements on page GR-1409

Witness my hand this 20th day of October, 1958

Lewis A. Stanley  
(State Engineer)

By \_\_\_\_\_ (Deputy)

GR-1409