

Registration Statement

OF CLAIMANT OF RIGHT TO APPROPRIATE GROUND WATER

TO THE STATE ENGINEER OF OREGON:

I, Walter Oldenburg
of 7595 Wheatland Road, Salem, Ore. County of Marion
(Mailing address)
State of Oregon, do hereby make application for a certificate of registration as evidence of a right to appropriate ground water.

1. Source from which water is withdrawn is Pump Well
(Flowing well, pump well, infiltration trench, or tunnel)

2. Location is: 6 1/2 miles North of Salem
(Approximate distance and direction from nearest city or town)

and is more particularly described as follows:

(a) 594' South & 16' East of N.E. Corner of Alvis Smith D.L.C.
(Give distance and bearing to corner of section or other legal subdivision)

being within N. W. 1/4 N. W. 1/4 of Sec. 26, Twp. 6S, Rge. 3W
(Smallest legal subdivision) (N. or S.) (E. or W.)

or (b) within limits of recorded platted property, town or city:

in Lot _____, Block _____ of _____
(Name of plat or addition)

County of _____
(If within city or town, give name)

3. Construction Work was begun on 6-1-47; was completed on 6-10-47
(Date) (Date)

and the ground water claimed was first used for the purposes set out below on 1947
(Date)

since which time the water has been used Intermittently
(Continuously or Intermittently)

from May to October
(Date) (Date)

4. Quantity of water claimed and used is 200 gallons per minute; 25 acre feet per year.

5. Purpose or Purposes for which water is used Irrigation

(Domestic, irrigation, municipal, manufacturing, industrial, etc.)

6. Description of Well: Depth 115 feet. Type Drilled
(Dug or drilled)

diameter 10 inches. Elevation of ground at well site 180 feet, mean sea level.
(As near as known)

Depth to water table 15 feet.

7. Capacity of Well: _____ g.p.m. with _____ feet drawdown.

_____ g.p.m. with _____ feet drawdown.


Date of test No test

If Flowing Well: Measured discharge _____ g.p.m. on _____
(Date)

Shut-in pressure at ground surface _____ lbs. per sq. in. on _____
(Date)

Water is controlled by _____
(Cap. valve, etc.)

Township 6S Range 3W, W.M.
North

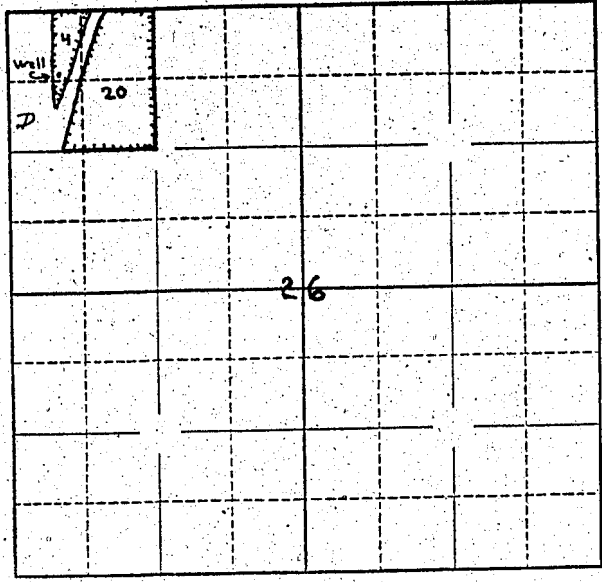

Locate well and acreage of irrigated land on plat.

Scale: $\frac{2\frac{1}{2}}{4}$ - 1 Mile

STATE OF OREGON }
County of Marion } ss.

I, Walter Oldenberg, being first duly sworn, do hereby certify that I have read the foregoing Registration Statement and that all of the items therein contained are true to the best of my knowledge and belief.

Walter Oldenberg
(Signature of Registrant)

Subscribed and sworn to before me this 21st day of April, 1958.

My commission expires Sept 8, 1958
Chris T. [Signature]
(Notary Public)

(SEAL)

CERTIFICATE OF REGISTRATION

STATE OF OREGON }
County of Marion } ss.

This is to certify that the foregoing Registration Statement, was received in the office of the State Engineer on the 21st day of April, 1958, at 1100 o'clock A. M. and has been duly recorded in said office in Book No. 7 of Registration Statements on page GR-1415

Witness my hand this 20th day of October, 1958

Lewis A. Stanley
(State Engineer)

By _____ (Deputy)

GR - 1415

#1,500