

Registration Statement

REGISTRATION NO. GR-147

CERTIFICATE NO. GR-141

OF CLAIMANT OF RIGHT TO APPROPRIATE GROUND WATER

(Under Chapter 708, Oregon Laws 1955.)

TO THE STATE ENGINEER OF OREGON:

I, J. F. and Stella Abbott
of 4203 Scholander Salem County of Marion

State of Oregon, do hereby make application for a certificate of registration as evidence of a right to appropriate ground water.

1. Source from which water is withdrawn is Well + Pump
(Flowing well, pump well, infiltration trench, or tunnel)

2. Location is: Four miles N.E. Salem Oregon
(Approximate distance and direction from nearest city or town)

and is more particularly described as follows:

(a) 830 feet south and 1200 feet east from NW 1/4 corner of section 8
(Give distance and bearing to corner of section or other legal subdivision)

being within NW 1/4 of NW 1/4 of Sec. 8, Twp. 7S, Rge. 2W
(Smallest legal subdivision) (N. or S.) (E. or W.)

or (b) within limits of recorded platted property, town or city:

in Lot _____, Block _____ of _____
(Name of plat or addition)

County of _____
(If within city or town, give name)

3. Construction Work was begun on Oct 15 - 1951; was completed on Nov 6, 1951
(Date) (Date)

and the ground water claimed was first used for the purposes set out below on June 1952
(Date)

since which time the water has been used Continuously
(Continuously or intermittently)

from 1952 to 1956
(Date) (Date)

4. Quantity of water claimed and used is 240 gallons per minute; 38 acre feet per year.

5. Purpose or Purposes for which water is used Irrigation
(Domestic, irrigation, municipal, manufacturing, industrial, etc.)

6. Description of Well: Depth 135 feet. Type Drilled
(Dug or drilled)
diameter 8" inches. Elevation of ground at well site _____ feet, mean sea level.
(As near as known)
Depth to water table 20 ft. feet.

7. Capacity of Well: 220 g.p.m. with 110 feet drawdown. 11/6/51
240 g.p.m. with 110 feet drawdown. 8/20/55

Date of test 11/6/51

If Flowing Well: Measured discharge _____ g.p.m. on _____
(Date)

Shut-in pressure at ground surface _____ lbs. per sq. in. on _____
(Date)

Water is controlled by _____
(Cap, valve, etc.)

8 inch diameter *steel casing* from 0 to 138 feet
 inch diameter from to feet
 inch diameter from 0 to feet
 inch diameter from to feet

Describe and show depth of shoe, plug, adapter, liner or other details:

Knife slots

(Number per foot and size of perforations, or describe screen)

from 82 to 138

from to

from to

from to

[illegible]

If log of well is not available, give name and address of driller. ~~Carl H. Saunders~~
 Carl H. Saunders

11. Infiltration Trench: Covered or open

Dimensions: Length ft. Minimum depth ft. Maximum depth ft.

Bottom width ft. Discharge g.p.m. Date of test

12. Tunnel: Type of lining

Dimensions: _____
(Length, course, and cross sectional size)

Position of water bearing stratum with reference to portal of tunnel

Log of tunnel: (Preceding table for log of well may be used, if desired. Give footage from portal and character of materials, as pertinent.)

13. Pumping Equipment:

(a) Pump Turbine Capacity 240 g.p.m.
(Make, type and size)

(b) Motor 20 H.P. Electric Motor
(Type and horsepower)


14. Location of area irrigated or to be irrigated, or place of use if for purposes other than irrigation.

[illegible]

15. If the ground water supply is supplemental to an existing water supply, identification of any application for a permit, permit, certificate or adjudicated right to appropriate water made or held by the registrant.

GR-141 B

Township 7S Range 2W W.M.
North

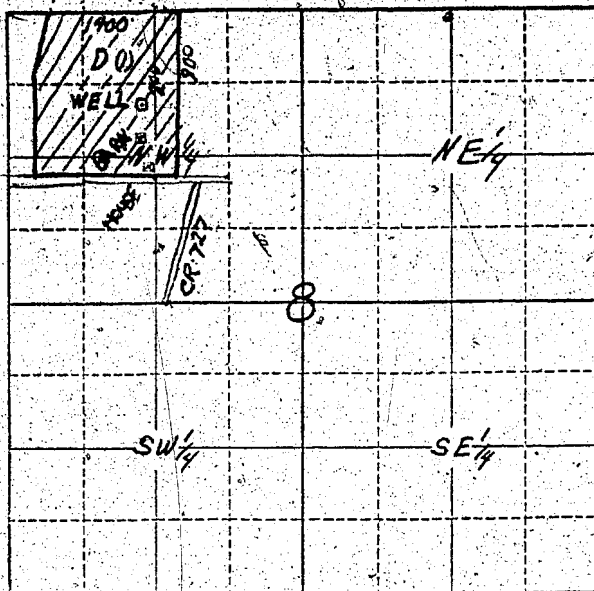

Locate well and acreage of irrigated land on plat.

Scale: $\frac{1}{4}$ " = 1 Mile

STATE OF OREGON

County of _____

ss.

I, J. F. Abbott, being first duly sworn, do hereby certify that I have read the foregoing Registration Statement and that all of the items therein contained are true to the best of my knowledge and belief.

J. F. Abbott
(Signature of Registrant)

Subscribed and sworn to before me this 23rd day of March, 1956.

My commission expires Sept 8, 1956

Ch. C. C. C.
(Notary Public)

(SEAL)

CERTIFICATE OF REGISTRATION

STATE OF OREGON

County of Marion

ss.

This is to certify that the foregoing Registration Statement was received in the office of the State Engineer on the 23rd day of March, 1956, at 10 o'clock A. M. and has been duly recorded in said office in Book No. 1 of Registration Statements on page GR-141 C. shall be ~~Construction shall be completed by~~ October 1, 1958. and the water completely applied to beneficial use by October 1, 1958.

Witness my hand this 8th day of October, 1956.

Lewis A. Stanley
(State Engineer)

By _____

(Deputy)

GR-141 C