

RECEIVED
APR 21 1958
STATE ENGINEER
SALEM, OREGON

Registration No. GR - 1470

Certificate No. GR - 1419

Registration Statement

OF CLAIMANT OF RIGHT TO APPROPRIATE GROUND WATER

TO THE STATE ENGINEER OF OREGON:

I, Howard Atkesson

of Rt. 3, Box 750, Albany County of Linn
(Mailing address)

State of Oregon, do hereby make application for a certificate of registration as evidence of a right to appropriate ground water.

1. Source from which water is withdrawn is Pump well No. 1
(Flowing well, pump well, infiltration trench, or tunnel)

2. Location is: 5 miles SW of Albany, Oregon
(Approximate distance and direction from nearest city or town)

and is more particularly described as follows:

(a) S. 76° 00' E. 39.5 chains from NW corner of SW 1/4, Sec. 21, T. 11 S., R. 4 W.
(Give distance and bearing to corner of section or other local subdivision)

being within NE 1/4 of SW 1/4 of Sec. 21, Twp. 11 S., Rge. 4 W.
(Smallest legal subdivision) (N. or S.) (E. or W.)

or (b) within limits of recorded platted property, town or city:

in Lot _____, Block _____ of _____
(Name of plat or addition)

County of Linn
(If within city or town, give name)

3. Construction Work was begun on April 1950; was completed on April 1950
(Date) (Date)

and the ground water claimed was first used for the purposes set out below on June 1950
(Date)

since which time the water has been used continuously
(Continuously or intermittently)

from June 1950 to present time
(Date) (Date)

4. Quantity of water claimed and used is 400 gallons per minute; 193.75 acre feet per year.

5. Purpose or Purposes for which water is used Irrigation

(Domestic, irrigation, municipal, manufacturing, industrial, etc.)

6. Description of Well: Depth 28 feet. Type Drilled
(Dug or drilled)

diameter 8 inches. Elevation of ground at well site 200 feet, mean sea level.
(As near as known)

Depth to water table 12 feet.

7. Capacity of Well: _____ g.p.m. with _____ feet drawdown.

_____ g.p.m. with _____ feet drawdown.

Date of test June 1950

If Flowing Well: Measured discharge _____ g.p.m. on _____
(Date)

Shut-in pressure at ground surface _____ lbs. per sq. in. on _____
(Date)

Water is controlled by _____
(Cap, valve, etc.)

8. Casing: (Give diameter, commercial specifications and depth below ground surface of each casing size.)

8 inch diameter steel casing from 0 to 28 feet
 inch diameter from to feet
 inch diameter from to feet
 inch diameter from to feet

Describe and show depth of shoe, plug, adapter, liner or other details:

9. Perforated Casings or Screens:

Slot perforations

from 20 to 28

(Number per foot and size of perforations, or describe screen)

from to

from to

from to

10. Log of Well: (Describe each stratum or formation clearly, indicate if water bearing, and give thickness and depth as indicated.)

MATERIAL	Thickness (Feet)	Depth to Bottom (Feet)
Not available		

do bargain, sell and convey unto Howard Atkeson.

the following described premises, to-wit

Beginning at a point 25 links south of the Northwest corner of the Donation Land Claim of Henry Watson, Notification No. 1786 and Claim No. 61 in Township 11 South, Range 4 West of the Willamette Meridian, Oregon, and running thence East 27.65 chains; thence North 25 links; thence West 20.25 chains; thence North 5.25 chains to the Northeast corner of the southeast quarter of the southwest quarter of Section 21 in said Township and Range; thence West 43.45 chains; thence South 18° 10' East to the Willamette River, thence following along said river to where said river intersects the west line of said Donation Land Claim No. 61, thence North along the west line of said Claim No. 61 to the place of beginning.

Also; beginning at a point on the North boundary line of the Donation Land Claim of Henry Watson, Notification No. 1786 and Claim No. 61 in Township 11 South, Range 4 West of the Willamette Meridian, Oregon, which is 27.65 chains East of the Northwest corner of said Claim and running thence South 30 feet, thence East to the center of the county road, thence Northerly along the center of said county road to the North line of said Claim No. 61, thence West along the North boundary line of said Claim No. 61 to the place of beginning, all in Linn County, Oregon.

The North half of the Southwest quarter of Section 21, T. 11 S., R. 4 W. of the Will. Mer. in Linn County, Oregon.

Beginning at the Northwest corner of the Southeast quarter of Section 21, T. 11 S., R. 4 W. of the Will. Mer. in Linn County, Oregon; and running thence South along the West line of the Southeast quarter of said Section 21 7.25 chains; thence East parallel with the North line of said Southeast quarter 20.25 chains to the center line of a county road; thence North 18° 10' East 43.45 chains; thence North 5.25 links; thence West 20.25 chains; thence North 25 links to the West line of the Southeast quarter of said Section; thence West 27.65 chains to the place of beginning.

If log of well is not available, give name and address of driller. Claude Schaeffer, Philomath, Oregon

11. Infiltration Trench: Covered or open

Dimensions: Length ft. Minimum depth ft. Maximum depth ft.

Bottom width ft. Discharge g.p.m. Date of test

12. Tunnel: Type of lining

Dimensions:
(Length, course, and cross sectional size)

Position of water bearing stratum with reference to portal of tunnel

Log of tunnel: (Preceding table for log of well may be used, if desired. Give footage from portal and character of materials, as pertinent.)

13. Pumping Equipment:

(a) Pump Pacific 3" centrifugal Capacity 500 g.p.m.
(Make, type and size)

(b) Motor 20 H. P. Hercules gasoline
(Type and horsepower)


14. Location of area irrigated or to be irrigated, or place of use if for purposes other than irrigation.

Township North or South	Range E. or W. of Willamette Meridian	Section	Forty-acre Tract	Number Acres To Be Irrigated	Date of Reclamation
11 S	4 W	21	NW $\frac{1}{4}$ of SW $\frac{1}{4}$	4.0	June 1950
11 S	4 W	21	NE $\frac{1}{4}$ of SW $\frac{1}{4}$	38.0	" "
11 S	4 W	21	NW $\frac{1}{4}$ of SE $\frac{1}{4}$	32.0	" "
11 S	4 W	21	NE $\frac{1}{4}$ of SE $\frac{1}{4}$	3.5	" "
				77.5	

Beginning at a point on the West boundary line of the Southeast quarter of Section 21, T. 11 S., R. 4 W. of the Will. Mer. in Linn County, Oregon; which is South 9.38 chains distant from the Northwest corner of the Southeast quarter of said Section 21, and running thence South 15.97 chains, more or less, to the North boundary line of the D.L.C. of Henry Watson, Claim No. 61 in said T. and R.; thence East along the North boundary line of said D.L.C. 27.49 chains, more or less, to the center of a county road; thence N.21°E. 8.87 chains; thence thence N.14°E. along the center of said county road 7.80 chains to a point directly East of the place of beginning, thence West 32.25 chains to the place of beginning, containing 43.40 acres, more or less, all lying and being in Linn County, State of Oregon.

15. If the ground water supply is supplemental to an existing water supply, identification of any application for a permit, permit, certificate or adjudicated right to appropriate water made or held by the registrant.

Township 11 S Range 4 W, W.M.
North

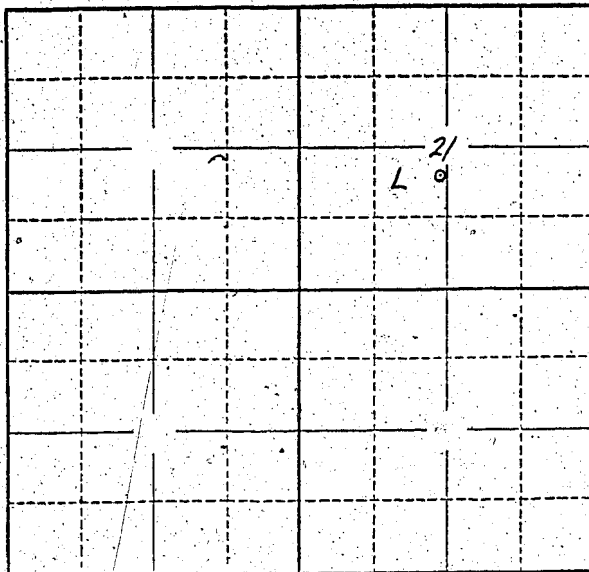

Map in
G943

Locate well and acreage of irrigated land on plat.
Scale: 2" = 1 Mile

STATE OF OREGON }
County of Linn } ss.

I, Howard Atkinson, being first duly sworn, do hereby certify that I have read the foregoing Registration Statement and that all of the items therein contained are true to the best of my knowledge and belief.

Howard Atkinson
(Signature of Registrant)

Subscribed and sworn to before me this 17th day of October, 1958

My commission expires 10/1/59 James B. Stanley
(Notary Public)

(SEAL)

CERTIFICATE OF REGISTRATION

STATE OF OREGON }
County of Marion } ss.

This is to certify that the foregoing Registration Statement was received in the office of the State Engineer on the 21st day of April, 1958, at 5:00 o'clock A. M. and has been duly recorded in said office in Book No. 7 of Registration Statements on page GR 1419

Witness my hand this 20th day of October, 1958

Lewis A. Stanley
(State Engineer)

By _____
(Deputy)