

# Registration Statement

STATE ENGINEER  
SALEM, OREGON

## OF CLAIMANT OF RIGHT TO APPROPRIATE GROUND WATER

TO THE STATE ENGINEER OF OREGON:

I, Harold & Elma Lister

of Route 3, Junction City County of Benton  
(Mailing address)

State of Oregon, do hereby make application for a certificate of registration as evidence of a right to appropriate ground water.

1. Source from which water is withdrawn is pump well  
(Flowing well, pump well, infiltration trench, or tunnel)

2. Location is: 3 miles east of Monroe  
(Approximate distance and direction from nearest city or town)

and is more particularly described as follows: 1222' N 13° E from set IP point, said point located

(a) 11.57 chains N 64° 2' E hence 1.88 chains N 9° E from the SW corner of the N $\frac{1}{4}$   
(Give distance and bearing to corner of section or other legal subdivision)

being within NW $\frac{1}{4}$  of Sec. 25, Twp. 14S, Rge. 5W  
(Smallest legal subdivision) (N. or S.) (E. or W.)

or (b) within limits of recorded platted property, town or city:

in Lot \_\_\_\_\_, Block \_\_\_\_\_ of \_\_\_\_\_  
(Name of plat or addition)

County of \_\_\_\_\_  
(If within city or town, give name)

3. Construction Work was begun on 1943; was completed on 1943  
(Date) (Date)

and the ground water claimed was first used for the purposes set out below on 1943  
(Date)

since which time the water has been used continuously  
(Continuously or intermittently)

from 1943 to 1943  
(Date) (Date)

4. Quantity of water claimed and used is 500/ gallons per minute; 75 acre feet per year, intermittently

5. Purpose or Purposes for which water is used irrigation

(Domestic, irrigation, municipal, manufacturing, industrial, etc.)

6. Description of Well: Depth 26 feet. Type driven  
(Dug or drilled)

diameter 4 inches. Elevation of ground at well site 250 feet, mean sea level.  
(As near as known)

Depth to water table 14 feet.  
400 sucked directly from casing

7. Capacity of Well 400 g.p.m. with \_\_\_\_\_ feet drawdown.

\_\_\_\_\_ g.p.m. with \_\_\_\_\_ feet drawdown.

Date of test 1943

If Flowing Well: Measured discharge \_\_\_\_\_ g.p.m. on \_\_\_\_\_  
(Date)

Shut-in pressure at ground surface \_\_\_\_\_ lbs. per sq. in. on \_\_\_\_\_  
(Date)

Water is controlled by \_\_\_\_\_  
(Cap, valve, etc.)

8. Casing: (Give diameter, commercial specifications and depth below ground surface of each casing size.)

4 inch diameter steel from surface to 26 feet  
 inch diameter from to feet  
 inch diameter from to feet  
 inch diameter from to feet

Describe and show depth of shoe, plug, adapter, liner or other details:  
 .....  
 .....

9. Perforated Casings or Screens:

Perforations unknown from 218 to 261  
 (Number per foot and size of perforations, or describe screen)  
 ..... from ..... to .....  
 ..... from ..... to .....  
 ..... from ..... to .....

10. Log of Well: (Describe each stratum or formation clearly, indicate if water bearing, and give thickness and depth as indicated.)

MATERIAL	Thickness (Feet)	Depth to Bottom (Feet)
unknown		

If log of well is not available, give name and address of driller. unknown

11. Infiltration Trench: Covered or open .....

Dimensions: Length ..... ft. Minimum depth ..... ft. Maximum depth ..... ft.  
 Bottom width ..... ft. Discharge ..... g.p.m. Date of test .....

12. Tunnel: Type of lining .....

Dimensions: .....  
 (Length, course, and cross sectional size)  
 Position of water bearing stratum with reference to portal of tunnel .....

Log of tunnel: (Preceding table for log of well may be used, if desired. Give footage from portal and character of materials, as pertinent.)

13: Pumping Equipment:

(a) Pump 4 x 3 Fairbanks Morse centrifugal Capacity 500 g.p.m.  
(Make, type and size)

(b) Motor gas tractor, 40 hp  
(Type and horsepower)


14. Location of area irrigated or to be irrigated, or place of use if for purposes other than irrigation.

Township North or South	Range E. or W. of Willamette Meridian	Section	Forty-acre Tract	Number Acres To Be Irrigated	Date of Reclamation
11S	5W	25	SW $\frac{1}{4}$ NW $\frac{1}{4}$	5.0	1943
11S	5W	25	NW $\frac{1}{4}$ NW $\frac{1}{4}$	18.0	1943
11S	5W	25	NE $\frac{1}{4}$ NW $\frac{1}{4}$	7.0	1943
				30.0	

15. If the ground water supply is supplemental to an existing water supply, identification of any application for a permit, permit, certificate or adjudicated right to appropriate water made or held by the registrant.

Township 14S Range 5W, W.M.

North

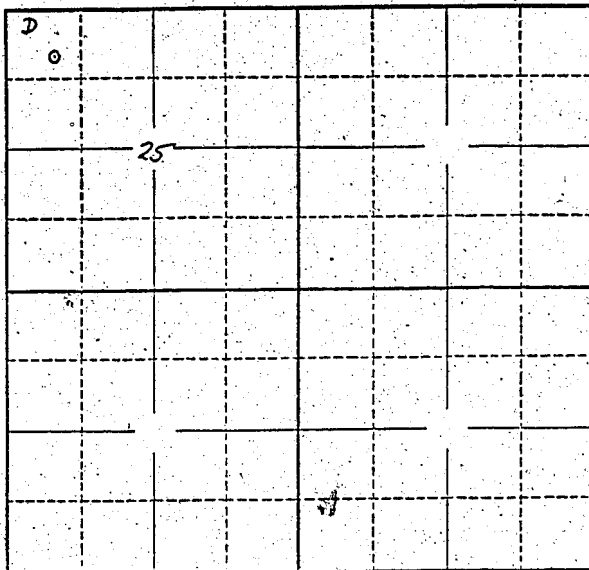

Locate well and acreage of irrigated land on plat.

Scale: 2" = 1 Mile

STATE OF OREGON

County of Linn } ss.

I, Harold J. Lister and Elma A Lister, being first duly sworn, do hereby certify that I have read the foregoing Registration Statement and that all of the items therein contained are true to the best of my knowledge and belief.

Harold J. Lister Elma A. Lister  
(Signature of Registrant)

Subscribed and sworn to before me this 19th day of April, 1958

My commission expires \_\_\_\_\_

(SEAL)

(Notary Public)

NOTARY PUBLIC  
My Commission Expires Sept. 25, 1959

CERTIFICATE OF REGISTRATION

STATE OF OREGON

County of Marion } ss.

This is to certify that the foregoing Registration Statement was received in the office of the State Engineer on the 21st day of April, 1958, at 8:00 o'clock A.M. and has been duly recorded in said office in Book No. 7 of Registration Statements on page GR-1420

Witness my hand this 20th day of October, 1958

Lewis A. Stanley  
(State Engineer)

By \_\_\_\_\_ (Deputy)

\$1,500