

RECEIVED

APR 20 1958
STATE ENGINEER
SALEM, OREGON

Registration Statement

REGISTRATION NO. GR-1481

CERTIFICATE NO. GR-1431

CLAIMANT OF RIGHT TO APPROPRIATE GROUND WATER

(Under Chapter 708, Oregon Laws 1955.)

2 registrations
1 map

TO THE STATE ENGINEER OF OREGON:

I, M. B. Clatterbuck, Supt. of Oregon State School for the Deaf
of Salem County of Marion

State of Oregon, do hereby make application for a certificate of registration as evidence of a right to appropriate ground water.

1. Source from which water is withdrawn is pump well, #1
(Flowing well, pump well, infiltration trench, or tunnel)
2. Location is: State School for the Deaf, 999 Locust St. Salem, Oregon
(Approximate distance and direction from nearest city or town)

and is more particularly described as follows:

(a) Approx. 3200 feet W. and 1570 feet south from NE corner Sect. 14
(Give distance and bearing to corner of section or other legal subdivision)

being within see map of Sec. 14, Twp. 1 South, Rge. 3 West
(Smallest legal subdivision) (N. or S.) (E. or W.)

or (b) within limits of recorded platted property, town or city: see map

in Lot see map, Block see map of Mapleton Addition
(Name of plat or addition)

see map County of Marion
(If within city or town, give name)

3. Construction Work was begun on not available 1920; was completed on before 1920
(Date) (Date)

and the ground water claimed was first used for the purposes set out below on before 1920
(Date)

since which time the water has been used continuously
(Continuously or intermittently)

from before 1920 to present
(Date) (Date)

4. Quantity of water claimed and used is 300 gallons per minute; acre feet per year.

5. Purpose or Purposes for which water is used Domestic and irrigation (Institution Supply)
(Domestic, irrigation, municipal, manufacturing, industrial, etc.)

6. Description of Well: Depth 30 feet. Type drilled
(Dug or drilled)

diameter inches. Elevation of ground at well site (a. prox 29) feet, mean sea level.
(As near as known)

Depth to water table 20 feet feet.

7. Capacity of Well: 400 g.p.m. with feet drawdown.
 g.p.m. with feet drawdown.

Date of test not available

If Flowing Well: Measured discharge g.p.m. on
(Date)

Shut-in pressure at ground surface lbs. per sq. in. on
(Date)

Water is controlled by
(Cap, valve, etc.)

eight	inch diameter	from	0	to	60	feet
	inch diameter	from		to		feet
	inch diameter	from		to		feet
	inch diameter	from		to		feet

Describe and show depth of shoe, plug, adapter, liner or other details:

not available

not available	from	to
(Number per foot and size of perforations, or describe screen)		
	from	to
	from	to
	from	to
	from	to

[illegible]

GR-1431

no records

- more**

Dimensions: Length ----- ft. Minimum depth ----- ft. Maximum depth ----- ft.

Bottom width ft. Discharge g.p.m. Date of test

- none

Dimensions: _____

(Length, course, and cross sectional size)

Position of water bearing stratum with reference to portal of tunnel --

Log of tunnel: (Preceding table for log of well may be used, if desired. Give footage from portal and character of materials, as pertinent.)

13. Pumping Equipment:

- (a) Pump 4" turbine pump Capacity 250 g.p.m.

(Make, type and size)

- (b) Motor US Motor 7½ HP on a Sterling pump

(Type and horsepower)

14. Location of area irrigated or to be irrigated, or place of use if for purposes other than irrigation.


[illegible]

15. If the ground water supply is supplemental to an existing water supply, identification of any application for a permit, permit, certificate or adjudicated right to appropriate water made or held by the registrant.

This well is connected to new well. Either one or both can be used for the same purpose.

GR- 1431

Township 7S Range R3W, W.M.
North

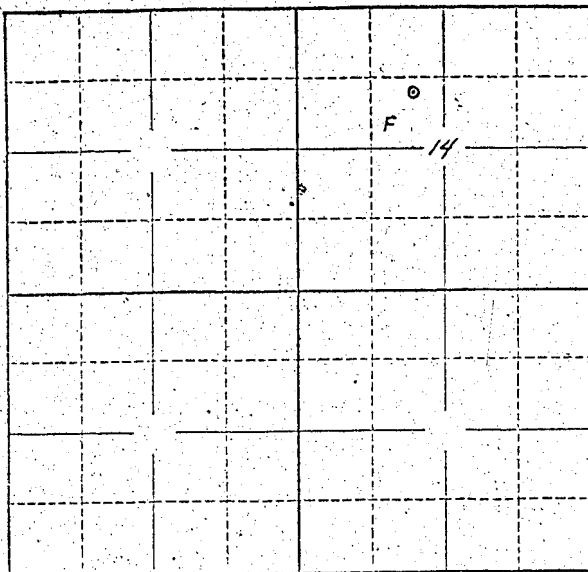

See map furnished
with this.

Locate well and acreage of irrigated land on plat.
Scale: 2" = 1 Mile

STATE OF OREGON

County of Marion } ss.

I, M. B. Clatterbuck, being first duly sworn, do hereby certify that I have read the foregoing Registration Statement and that all of the items therein contained are true to the best of my knowledge and belief.

M. B. Clatterbuck
(Signature of Registrant)

Subscribed and sworn to before me this 26th day of Feb, 1958.

My commission expires 7-19-59

Emilio R. Hart
(Notary Public)

(SEAL)

CERTIFICATE OF REGISTRATION

STATE OF OREGON

County of Marion } ss.

This is to certify that the foregoing Registration Statement was received in the office of the State Engineer on the 22 day of April, 1958, at 8:00 o'clock A.M. and has been duly recorded in said office in Book No. 7 of Registration Statements on page GR-1431

~~Construction shall be completed by 19 and the water completely opened to beneficiaries by 19~~

Witness my hand this 1st day of December, 1958.

LEWIS L. STANLEY
(State Engineer)

By Max F. Rogers
(Deputy)

GR-1431