

RECEIVED

APR 22 1958

Registration Statement

REGISTRATION NO. GR-1482
CERTIFICATE NO. GR-1432

STATE ENGINEER CLAIMANT OF RIGHT TO APPROPRIATE GROUND WATER
SALEM, OREGON

(Under Chapter 708, Oregon Laws 1955.)

2 registrations
1 map

TO THE STATE ENGINEER OF OREGON:

I, M. B. Clatterbuck, Supt. Oregon State School for the Deaf

of Salem County of Marion

State of Oregon, do hereby make application for a certificate of registration as evidence of a right to appropriate ground water.

1. Source from which water is withdrawn is pump well #2 (Flowing well, pump well, infiltration trench, or tunnel)

2. Location is: State School for the Deaf, 999 Locust St. Salem, Oregon (Approximate distance and direction from nearest city or town)

and is more particularly described as follows:

(a) 3340 feet west & 1350 feet south from NE corner Section 14 (Give distance and bearing to corner of section or other legal subdivision)

being within SE 1/4 of NW 1/4 of Sec. 14, Twp. 7 south, Rge. 3 west (Smallest legal subdivision) (N. or S.) (E. or W.)

or (b) within limits of recorded platted property, town or city: See Map

in Lot ---, Block --- of Mapleton Addition (Name of plat or addition)

County of Marion (If within city or town, give name)

3. Construction Work was begun on August, 1950; was completed on Oct., 1950 (Date) (Date)

and the ground water claimed was first used for the purposes set out below on Oct., 1950 (Date)

since which time the water has been used continuously (Continuously or Intermittently)

from Oct., 1950 to present (Date) (Date)

4. Quantity of water claimed and used is 100 gallons per minute; acre feet per year.

5. Purpose or Purposes for which water is used Domestic and irrigation (Institution Supply)

(Domestic, irrigation, municipal, manufacturing, industrial, etc.)

6. Description of Well: Depth 153 feet. Type drilled (Dug or drilled)

diameter 10 inches. Elevation of ground at well site 27.1 feet, mean sea level. (As near as known)

Depth to water table 20 feet.

7. Capacity of Well: 620 g.p.m. with --- feet drawdown.

--- g.p.m. with --- feet drawdown.


Date of test ---

If Flowing Well: Measured discharge --- g.p.m. on --- (Date)

Shut-in pressure at ground surface --- lbs. per sq. in. on --- (Date)

Water is controlled by --- (Cap, valve, etc.)

Township 75 Range 3W, W.M.
North

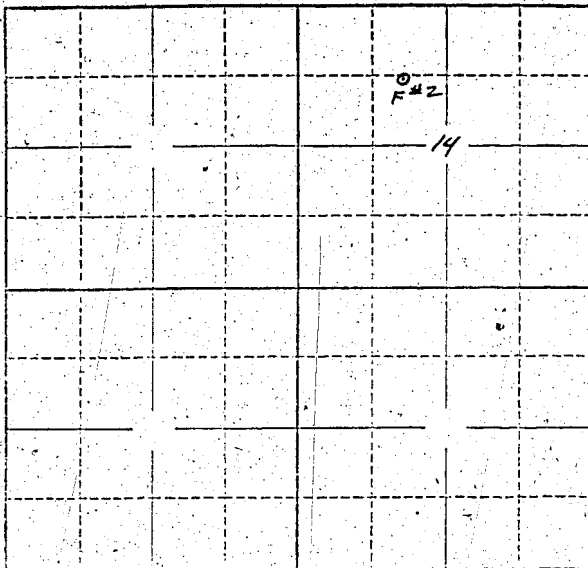

See map furnished
with this.

Locate well and acreage of irrigated land on plat.

Scale: 2" = 1 Mile

STATE OF OREGON

County of Marion

ss.

I, M. B. Clatterbuck, being first duly sworn, do hereby certify that I have read the foregoing Registration Statement and that all of the items therein contained are true to the best of my knowledge and belief.

M. B. Clatterbuck
(Signature of Registrant)

Subscribed and sworn to before me this 26th day of Feb, 1958

My commission expires 7-19-59

Erinice R. Hart
(Notary Public)

(SEAL)

CERTIFICATE OF REGISTRATION

STATE OF OREGON

County of Marion

ss.

This is to certify that the foregoing Registration Statement was received in the office of the State Engineer on the 22nd day of April, 1958, at 8⁰⁰ o'clock A. M. and has been duly recorded in said office in Book No. 7 of Registration Statements on page GR-1432

~~Construction shall be completed by 1958 and the water completely applied to beneficial use by 1958~~

Witness my hand this 1st day of December....., 1958

LEWIS A. STANLEY
(State Engineer)

By Mak F. Rogers
(Deputy)

GR-1432

\$ 28.00