

Registration Statement

OF CLAIMANT OF RIGHT TO APPROPRIATE GROUND WATER

TO THE STATE ENGINEER OF OREGON:

I, Leonard F. Lorenzen
of 110 NE Funnish Bendleton County of umatilla
(Mailing address)
State of Oregon, do hereby make application for a certificate of registration as evidence
of a right to appropriate ground water.

1. Source from which water is withdrawn is Pump well
(Flowing well, pump well, infiltration trench, or tunnel)
2. Location is: 1 1/2 miles North West of Milton-Freewater
(Approximate distance and direction from nearest city or town)

and is more particularly described as follows:

(a) 375 feet South of NE Corner of SW 4 of NE 4
(Give distance and bearing to corner of section or other legal subdivision)
being within SW 4 of NE 4 of Sec. 34, Twp. 6N, Rge. 35E
(Smallest legal subdivision) (N. or S.) (E. or W.)
or (b) within limits of recorded platted property, town or city:
in Lot _____, Block _____ of _____
(Name of plat or addition)

County of _____
(If within city or town, give name)

3. Construction Work was begun on 1908; was completed on Same
(Date) (Date)
and the ground water claimed was first used for the purposes set out below on 1908
(Date)
since which time the water has been used Intermittently
(Continuously or intermittently)
from 1908 to 1958
(Date) (Date)

4. Quantity of water claimed and used is 400 gallons per minute; _____ acre
feet per year.

5. Purpose or Purposes for which water is used Irrigation & Domestic

(Domestic, irrigation, municipal, manufacturing, industrial, etc.)

6. Description of Well: Depth 100 feet. Type 42 feet Aug - 58 feet Drilled
6 1/8" Aug 12 Drilled (Aug or drilled)
diameter 12 inches. Elevation of ground at well site 900 feet, mean sea level.
(As near as known)
Depth to water table 42 feet. Dec 1957
No test

7. Capacity of Well: _____ g.p.m. with _____ feet drawdown.
_____ g.p.m. with _____ feet drawdown.

Date of test _____

If Flowing Well: Measured discharge _____ g.p.m. on _____
(Date)

Shut-in pressure at ground surface _____ lbs. per sq. in. on _____
(Date)

Water is controlled by _____
(Cap, valve, etc.)

6"x6"	inch diameter	Concrete	from 0	to 15	feet
12	inch diameter	Steel	from 15	to 60	feet
	inch diameter		from	to	feet
	inch diameter		from	to	feet

Describe and show depth of shoe, plug, adapter, liner or other details: _____


(Number per foot and size of perforations, or describe screen)	from	to
	from	to
	from	to
	from	to
	from	to

10. **Log of Well:** (Describe each stratum or formation clearly, indicate if water bearing, and give thickness and depth as indicated.)

[illegible]

GR. 1516

Township 6 N Range 3 SE W.M.
North

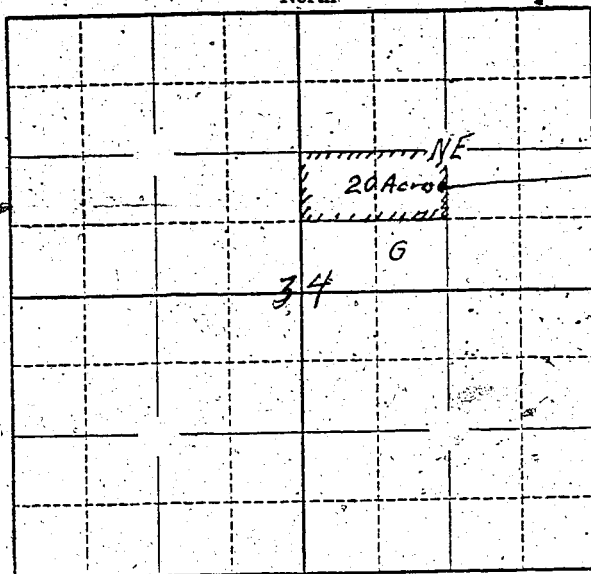

Well Location
375 feet South of
NE corner of SW 4
of NE 1/4 of Sec 34

Locate well and acreage of irrigated land on plat.

Scale: 1/4 - 1 Mile

STATE OF OREGON

County of UMATILLA

ss.

I, LEONARD F. LORENZEN, being first duly sworn, do hereby certify that I have read the foregoing Registration Statement and that all of the items therein contained are true to the best of my knowledge and belief.

Leonard F. Lorenzen
(Signature of Registrant)

Subscribed and sworn to before me this 3 day of November, 1958

My commission expires 4-17-64

Betty Ewing
(Notary Public)

(SEAL)

CERTIFICATE OF REGISTRATION

STATE OF OREGON

County of Marion

ss.

This is to certify that the foregoing Registration Statement was received in the office of the State Engineer on the 22nd day of April, 1958, at 1:00 o'clock P. M. and has been duly recorded in said office in Book No. 7 of Registration Statements on page GR-1516

Witness my hand this 1st day of December, 1958

Leura A. B. B. B.
(State Engineer)

By

(Deputy)

GR-1516