

Registration Statement

OF CLAIMANT OF RIGHT TO APPROPRIATE GROUND WATER

TO THE STATE ENGINEER OF OREGON:

I, Henry Oswald Berning
of Route 1, Box 2 Gervais County of Marion
(Mailing address)

State of Oregon, do hereby make application for a certificate of registration as evidence of a right to appropriate ground water.

1. Source from which water is withdrawn is Pump well
(Flowing well, pump well, infiltration trench, or tunnel)

2. Location is: 1/4 mile south of City limits of Gervais
(Approximate distance and direction from nearest city or town)

and is more particularly described as follows:

(a) 670' W. and 250' S. from the NE corner of the SE 1/4 of SW 1/4
(Give distance and bearing to corner of section or other legal subdivision)

being within SE 1/4 of SW 1/4 of Sec. 26, Twp. 5 S, Rge. 2 W
(Smallest legal subdivision) (N. or S.) (E. or W.)

or (b) within limits of recorded platted property, town or city:

in Lot _____, Block _____ of _____
(Name of plat or addition)

County of _____
(If within city or town, give name)

3. Construction Work was begun on Sept 1951; was completed on Sept - 1951
(Date) (Date)

and the ground water claimed was first used for the purposes set out below on Sept - 1951
(Date)

since which time the water has been used intermittently
(Continuously or intermittently)

from May 1951 to Oct 1
(Date) (Date)

4. Quantity of water claimed and used is 450 gallons per minute; 1.25 acre feet per year.

5. Purpose or Purposes for which water is used irrigation

(Domestic, irrigation, municipal, manufacturing, industrial, etc.)

6. Description of Well: Depth 136 feet. Type drilled
(Dug or drilled)

diameter 10 inches. Elevation of ground at well site _____ feet, mean sea level.
(As near as known)

Depth to water table 30 feet.

7. Capacity of Well: 720 g.p.m. with 87 feet drawdown.

_____ g.p.m. with _____ feet drawdown.

Date of test Sept 1951

If Flowing Well: Measured discharge _____ g.p.m. on _____
(Date)

Shut-in pressure at ground surface _____ lbs. per sq. in. on _____
(Date)

Water is controlled by _____
(Cap, valve, etc.)

8. Casing: (Give diameter, commercial specifications and depth below ground surface of each casing size.)

10 inch diameter from 0 to 136 feet
..... inch diameter from to feet
..... inch diameter from to feet
..... inch diameter from to feet

Describe and show depth of shoe, plug, adapter, liner or other details:

9. Perforated Casings or Screens:

Mills Perforation from 124 ft to 136 ft
(Number per foot and size of perforations, or describe screen)
..... from to
..... from to
..... from to

10. Log of Well: (Describe each stratum or formation clearly, indicate if water bearing, and give thickness and depth as indicated.)

MATERIAL	Thickness (Feet)	Depth to Bottom (Feet)
Unknown		

If log of well is not available, give name and address of driller: Waymond Hall
drilling Co - Beaverton Oregon

11. Infiltration Trench: Covered or open
 Dimensions: Length ft. Minimum depth ft. Maximum depth ft.
 Bottom width ft. Discharge g.p.m. Date of test

12. Tunnel: Type of lining
 Dimensions:
(Length, course, and cross sectional size)
 Position of water bearing stratum with reference to portal of tunnel

Log of tunnel: (Preceding table for log of well may be used, if desired. Give footage from portal and character of materials, as pertinent.)


13. Pumping Equipment:
 (a) Pump Jacuzzi - turbine Capacity 450 g.p.m.
(Make, type and size)
 (b) Motor A & Smith - 3 Phase - 20 horsepower 240V
(Type and horsepower)

14. Location of area irrigated or to be irrigated, or place of use if for purposes other than irrigation.

Township North or South	Range E. or W. of Willamette Meridian	Section	Forty-acre Tract	Number Acres To Be Irrigated	Date of Reclamation
5S	2W	26	NE $\frac{1}{4}$ SW $\frac{1}{4}$	9.7	Sept. 1951
5S	2W	26	NW $\frac{1}{4}$ SW $\frac{1}{4}$	17.5	"
5S	2W	26	SW $\frac{1}{4}$ SW $\frac{1}{4}$	10.1	"
5S	2W	26	SE $\frac{1}{4}$ SW $\frac{1}{4}$	11.9	"
				49.2	

15. If the ground water supply is supplemental to an existing water supply, identification of any application for a permit, permit, certificate or adjudicated right to appropriate water made or held by the registrant.
None

Township 55 Range 2W W.M.
North

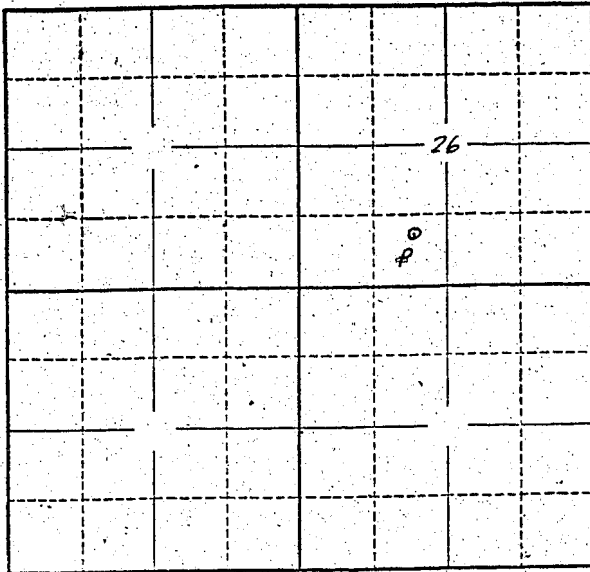

Locate well and acreage of irrigated land on plat.
Scale: 2" = 1 Mile

STATE OF OREGON }
County of Marion } ss.

I, Henry O. Berning, being first duly sworn, do hereby certify that I have read the foregoing Registration Statement and that all of the items therein contained are true to the best of my knowledge and belief.

Henry O. Berning
(Signature of Registrant)

Subscribed and sworn to before me this 22nd day of April, 1958.

My commission expires Sept. 8, 1960

Chas. J. ...
(Notary Public)

(SEAL)

CERTIFICATE OF REGISTRATION

STATE OF OREGON }
County of Marion } ss.

This is to certify that the foregoing Registration Statement was received in the office of the State Engineer on the 22nd day of April, 1958, at 8⁰⁰ o'clock A. M. and has been duly recorded in said office in Book No. 7 of Registration Statements on page GR-1433

Witness my hand this 1st day of December, 1958.

Laura A. Standen
(State Engineer)

By _____
(Deputy)