

Registration Statement

OF CLAIMANT OF RIGHT TO APPROPRIATE GROUND WATER

TO THE STATE ENGINEER OF OREGON:

I, H. Ralph DuPette
of P.O. Box 266 Gervais County of Marion
(Mailing address)
State of Oregon, do hereby make application for a certificate of registration as evidence of a right to appropriate ground water.

- Source from which water is withdrawn is sump well
(Flowing well, sump well, infiltration trench, or tunnel)
- Location is: five miles west of Gervais
(Approximate distance and direction from nearest city or town)

and is more particularly described as follows:

(a) 1100' N & 900' E from E/4 corner section 25, being within
(Give distance and bearing to corner of section or other legal subdivision)
being within SW 1/4 NW 1/4 of Sec. 30, Twp. 5S, Rge. 2W
(Smallest legal subdivision) (N. or S.) (E. or W.)

or (b) within limits of recorded platted property, town or city:
in Lot _____, Block _____ of _____
(Name of plat or addition)

County of _____
(If within city or town, give name)

3. Construction Work was begun on July 10-49 was completed on July 15-49
(Date) (Date)
and the ground water claimed was first used for the purposes set out below on July 18-49
(Date)
since which time the water has been used continuously
(Continuously or Intermittently)
from July 18, 1949 to Oct. 1957
(Date) (Date)

4. Quantity of water claimed and used is 540 gallons per minute; _____ acre feet per year.

5. Purpose or Purposes for which water is used irrigation of farm crops
(Domestic, irrigation, municipal, manufacturing, industrial, etc.)

6. Description of Well: Depth 53 feet. Type drilled
(Dug or drilled)
diameter 10 inches. Elevation of ground at well site 40 feet, mean sea level.
(As near as known)
Depth to water table 6 feet.

7. Capacity of Well: 500 g.p.m. with 3 feet drawdown.
_____ g.p.m. with _____ feet drawdown.

Date of test July 15-49

If Flowing Well: Measured discharge _____ g.p.m. on _____
(Date)

Shut-in pressure at ground surface _____ lbs. per sq. in. on _____
(Date)

Water is controlled by _____
(Cap, valve, etc.)

8. Casing: (Give diameter, commercial specifications and depth below ground surface of each casing size.)

10 inch diameter from 0 to 53 feet
inch diameter from to feet
inch diameter from to feet
inch diameter from to feet

Describe and show depth of shoe, plug, adapter, liner or other details:

9. Perforated Casings or Screens:

perforated (Number per foot and size of perforations, or describe screen) from 35 to 53
from to
from to
from to

10. Log of Well: (Describe each stratum or formation clearly, indicate if water bearing, and give thickness and depth as indicated.)

MATERIAL	Thickness (Feet)	Depth to Bottom (Feet)
clay	9	
sand	12	
sand & rock	32	

If log of well is not available, give name and address of driller.

G. J. Miller

Aurora Ore.

11. Infiltration Trench: Covered or open

Dimensions: Length _____ ft. Minimum depth _____ ft. Maximum depth _____ ft.

Bottom width _____ ft. Discharge _____ g.p.m. Date of test _____

12. Tunnel: Type of lining

Dimensions: _____
(Length, course, and cross sectional size)

Position of water bearing stratum with reference to portal of tunnel _____

Log of tunnel: (Preceding table for log of well may be used, if desired. Give footage from portal and character of materials, as pertinent.)

13. Pumping Equipment:

(a) Pump *centrifugal G.M.* Capacity *500* g.p.m.
(Make, type and size)

(b) Motor *G.M.* *20*
(Type and horsepower)


14. Location of area irrigated or to be irrigated, or place of use if for purposes other than irrigation.

Township North or South	Range E. or W. of Williamsite Meridian	Section	Forty-acre Tract	Number Acres To Be Irrigated	Date of Reclamation
55	2W	19	SW ¹ / ₄ SW ¹ / ₄	20	1949
"	"	30	NW ¹ / ₄ NW ¹ / ₄	40	"
"	"	"	SW ¹ / ₄ NW ¹ / ₄	40	"
55	3W	25	NE ¹ / ₄ NE ¹ / ₄	22	"
"	"	"	SE ¹ / ₄ NE ¹ / ₄	30	"
"	"	"	NE ¹ / ₄ SE ¹ / ₄	5	"
				Total 157 ac	

15. If the ground water supply is supplemental to an existing water supply, identification of any application for a permit, permit, certificate or adjudicated right to appropriate water made or held by the registrant.

None

Township 55 Range R243, W.M.
North

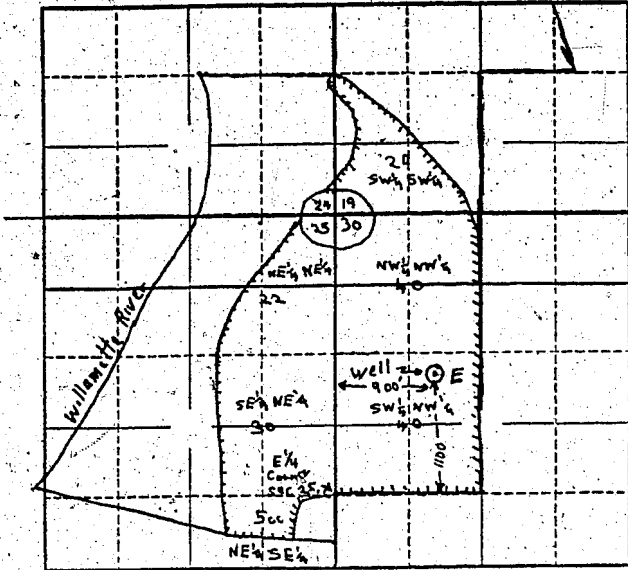

Locate well and acreage of irrigated land on plat.

Scale: $\frac{1}{4}$ " = 1 Mile

STATE OF OREGON

County of Marion } ss.

I, F. Ralph DuRette, being first duly sworn, do hereby certify that I have read the foregoing Registration Statement and that all of the items therein contained are true to the best of my knowledge and belief.

F. Ralph DuRette
(Signature of Registrant)

Subscribed and sworn to before me this 22nd day of April, 1958.

My commission expires Sept. 8, 1960

[Signature]
(Notary Public)

(SEAL)

CERTIFICATE OF REGISTRATION

STATE OF OREGON

County of Marion } ss.

This is to certify that the foregoing Registration Statement was received in the office of the State Engineer on the 22nd day of April, 1958, at 8⁰⁰ o'clock A.M. and has been duly recorded in said office in Book No. 7 of Registration Statements on page GR-1436.

Witness my hand this 1st day of December, 1958.

[Signature]
(State Engineer)

By [Signature]
(Deputy)