

Registration Statement

OF CLAIMANT OF RIGHT TO APPROPRIATE GROUND WATER

(Under Chapter 708, Oregon Laws 1955.)

TO THE STATE ENGINEER OF OREGON:

I, JESSIE E. MOUDY.

of Whittier County of Los Angeles

State of California, do hereby make application for a certificate of registration as evidence of a right to appropriate ground water.

1. Source from which water is withdrawn is pump well
(Flowing well, pump well, infiltration trench, or tunnel)

2. Location is: approx. 10 miles North of Salem, Oregon.
(Approximate distance and direction from nearest city or town)

and is more particularly described as follows:

(a) 100 ft. N. and 380 Ft. W. of the SE corner of the SW quarter of the N.E. quarter of the SW quarter of NE 1/4 of Sec. 9, Twp. 8 S., Rge. 3 E. of the willamette meridian
(Give distance and bearing to corner of section or other legal subdivision)
or (b) within limits of recorded platted property, town or city: in Marion County, Oregon.
(N. or S.) (E. or W.)

in Lot _____, Block _____ of _____
(Name of plat or addition)

County of _____
(If within city or town, give name)

3. Construction Work was begun on October, 1954; was completed on October, 1954
(Date) (Date)

and the ground water claimed was first used for the purposes set out below on October, 1954
(Date)

since which time the water has been used continuously when needed for irrigation purposes.
(Continuously or intermittently)

from October, 1954, to September, 1956.
(Date) (Date)

4. Quantity of water claimed and used is 450 gallons per minute; _____ acre feet per year.

5. Purpose or Purposes for which water is used domestic and irrigation

(Domestic, irrigation, municipal, manufacturing, industrial, etc.)

6. Description of Well: Depth 85 feet, Type drilled
(Dug or drilled)

diameter 10 inches. Elevation of ground at well site _____ feet, mean sea level.
(As near as known)

Depth to water table 23 feet.

7. Capacity of Well: _____ g.p.m. with _____ feet drawdown.

_____ g.p.m. with _____ feet drawdown.

Date of test _____

If Flowing Well: Measured discharge _____ g.p.m. on _____
(Date)

Shut-in pressure at ground surface _____ lbs. per sq. in. on _____
(Date)

Water is controlled by _____
(Cap, valve, etc.)

If log of well is not available, give name and address of driller. Studebaker Bros., Salem, Oregon.

11. Infiltration Trench: Covered or open

Dimensions: Length ft. Minimum depth ft. Maximum depth ft.

Bottom width ft. Discharge g.p.m. Date of test

12. Tunnel: Type of lining

Dimensions:
(Length, course, and cross sectional size)

Position of water bearing stratum with reference to portal of tunnel

Log of tunnel: (Preceding table for log of well may be used, if desired. Give footage from portal and character of materials, as pertinent.)

13. Pumping Equipment:

(a) Pump 40 H. P. Electric Pump (Turbine) Capacity 500 g.p.m.
(Make, type and size)

(b) Motor 40 H. P. Electric Pump 30 hp. dwt
(Type and horsepower)


14. Location of area irrigated or to be irrigated, or place of use if for purposes other than irrigation.

| Township North or South | Range E. or W. of Willamette Meridian | Section | Forty-acre Tract | Number Acres To Be Irrigated | Date of Reclamation |
|-------------------------|---------------------------------------|----------|---|------------------------------|---------------------|
| 6 South | 3 west | Nine (9) | Lot One (1) | | |
| 6 South | 3 west | Nine (9) | Lot Two (2) | | |
| | | | East Half of the Northeast Quarter | | Total 178.36 acres |
| | | | Southeast Quarter (SE $\frac{1}{4}$) of Northeast Quarter (NE $\frac{1}{4}$) | 40 | |
| | | | Southwest Quarter (SW $\frac{1}{4}$) of Northeast Quarter (NE $\frac{1}{4}$) | 15 | |
| | | | Northwest Quarter (NW $\frac{1}{4}$) of Northeast Quarter (NE $\frac{1}{4}$) | 2 | |
| | | | Total | 57 | |
| | | | The date on which water was first used on the above parcels of land was in the month of June, 1955. | | |

15. If the ground water supply is supplemental to an existing water supply, identification of any application for a permit, permit, certificate or adjudicated right to appropriate water made or held by the registrant.

Township 6 South Range 3 West, W.M.

North

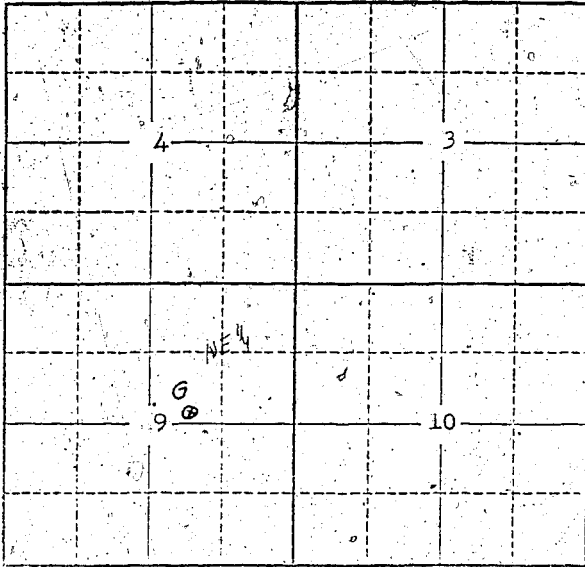

Locate well and acreage of irrigated land on plat.

Scale: 2" = 1 Mile

CALIFORNIA
STATE OF OREGON

County of _____ } ss.

I, JESSIE E. MOUDY, being first duly sworn, do hereby certify that I have read the foregoing Registration Statement and that all of the items therein contained are true to the best of my knowledge and belief.

Jessie E. Moudy
(Signature of Registrant)

Subscribed and sworn to before me this 24th day of September, 1956.

My commission expires July 14, 1956.

W. B. Brown
Notary Public (Notary Public) California

(SEAL)

CERTIFICATE OF REGISTRATION

STATE OF OREGON } ss.
County of Marion

This is to certify that the foregoing Registration Statement was received in the office of the State Engineer on the 23rd day of April, 1958, at _____ o'clock _____ M. and has been duly recorded in said office in Book No. _____ of Registration Statements on page GR-1565.

~~Construction shall be completed by _____ 19____ and the water completely applied to beneficial use by _____ 19____.~~

Witness my hand this _____ 1st day of December, 1958.

Levin A. [Signature]
(State Engineer)

By _____ (Deputy)

GR-1565

\$29.15