

RECEIVED  
MAR 23 1956  
STATE ENGINEER  
SALEM, OREGON

REGISTRATION NO. GR-149

CERTIFICATE NO. GR-142

### Registration Statement

#### OF CLAIMANT OF RIGHT TO APPROPRIATE GROUND WATER

(Under Chapter 708, Oregon Laws 1955.)

TO THE STATE ENGINEER OF OREGON:

I, Roy Ledbury  
of Boring County of Clackamas  
State of Oregon, do hereby make application for a certificate of registration as evidence of a right to appropriate ground water.

1. Source from which water is withdrawn is: Pump Well  
(Flowing well, pump well, infiltration trench, or funnel)

2. Location is: 1 mi. East - 1 mi. North of Damascus  
(Approximate distance and direction from nearest city or town)

and is more particularly described as follows:

(a) 513 ft. N. from S.E. corner of sec. 20 feet west.  
(Give distance and bearing to corner of section or other legal subdivision)

being within SE 1/4 of SE 1/4 of Sec. 33 Twp. 1 S Rge. 3 E  
(Smallest legal subdivision) (N. or S.) (E. or W.)

or (b) within limits of recorded platted property, town or city:

in Lot \_\_\_\_\_ Block \_\_\_\_\_ of \_\_\_\_\_  
(Name of plat or addition)

County of \_\_\_\_\_  
(If within city or town, give name)

3. Construction Work was begun on April 5 '55; was completed on April 28 '55  
(Date) (Date)

and the ground water claimed was first used for the purposes set out below on June 1955  
(Date)

since which time the water has been used Continuously  
(Continuously or intermittently)

from June 1955 to Present  
(Date) (Date)

4. Quantity of water claimed and used is 108 gallons per minute; 7 acre feet per year.

5. Purpose or Purposes for which water is used Domestic and irrigation  
(Domestic, irrigation, municipal, manufacturing, industrial, etc.)

6. Description of Well: Depth 325 feet. Type drilled  
(Dug or drilled)

diameter 8 inches. Elevation of ground at well site 650' ~~500~~ Approx. feet, mean sea level.  
(As near as known)

Depth to water table 205 feet.

7. Capacity of Well: 170 g.p.m. with 20 feet drawdown.  
\_\_\_\_\_ g.p.m. with \_\_\_\_\_ feet drawdown.

Date of test April 28, 1955

If Flowing Well: Measured discharge \_\_\_\_\_ g.p.m. on \_\_\_\_\_  
(Date)

Shut-in pressure at ground surface \_\_\_\_\_ lbs. per sq. in. on \_\_\_\_\_  
(Date)

Water is controlled by \_\_\_\_\_  
(Cap, valve, etc.)

8. Casing: (Give diameter, commercial specifications and depth below ground surface of each casing size.)

8 inch diameter *standard* from 0 to 265 feet  
 5 inch diameter *"* from 265 to 325 feet  
 inch diameter from to feet  
 inch diameter from to feet

Describe and show depth of shoe, plug, adapter, liner or other details:

*Gravel packed around 5 in lines*

9. Perforated Casings or Screens:

*1/4" wide 1' long spaced continuously* from 290 to 325  
(Number per foot and size of perforations, or describe screen)  
 from to  
 from to  
 from to

10. Log of Well: (Describe each stratum or formation clearly, indicate if water bearing, and give thickness and depth as indicated.)

MATERIAL	Thickness (Feet)	Depth to Bottom (Feet)
<i>The U.S. Geologic Survey has a copy of the well log but our copy has been misplaced</i>		

If log of well is not available, give name and address of driller. F. O. Olsen  
Geesham, Oregon

11. Infiltration Trench: Covered or open .....  
 Dimensions: Length ..... ft. Minimum depth ..... ft. Maximum depth ..... ft.  
 Bottom width ..... ft. Discharge ..... g.p.m. Date of test .....

12. Tunnel: Type of lining .....  
 Dimensions: .....  
(Length, course, and cross sectional size)  
 Position of water bearing stratum with reference to portal of tunnel .....

Log of tunnel: (Preceding table for log of well may be used, if desired. Give footage from portal and character of materials, as pertinent.)

13. Pumping Equipment:


(a) Pump Jacuzzi Submersible Capacity 10.8 g.p.m.  
(Make, type and size)  
 (b) Motor 3 Phase 15 horse  
(Type and horsepower)

14. Location of area irrigated or to be irrigated, or place of use if for purposes other than irrigation.

Township North or South	Range E. or W. of Willamette Meridian	Section	Forty-acre Tract	Number Acres To Be Irrigated	Date of Reclamation
<u>1S</u>	<u>3E</u>	<u>33</u>	<u>SE<math>\frac{1}{4}</math> of SE<math>\frac{1}{4}</math></u>	<u>18.5 Acres</u>	<u>June 1955</u>

15. If the ground water supply is supplemental to an existing water supply, identification of any application for a permit, permit, certificate or adjudicated right to appropriate water made or held by the registrant.

Township 15 Range 3E W.M.  
North

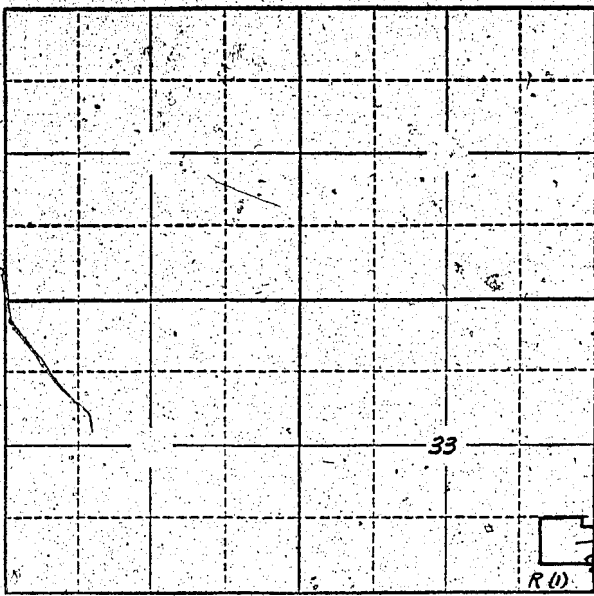

Locate well and acreage of irrigated land on plat.  
Scale: 2" = 1 Mile

STATE OF OREGON

County of CLATSOP } ss.

I, Roy LEDBURY being first duly sworn, do hereby certify that I have read the foregoing Registration Statement and that all of the items therein contained are true to the best of my knowledge and belief.

Roy Ledbury  
(Signature of Registrant)

Subscribed and sworn to before me this 29 day of February, 1956

My commission expires NOTARY PUBLIC FOR OREGON  
My Commission Expires Oct. 18, 1956

Ernest Thomas  
(Notary Public)

(SEAL)

**CERTIFICATE OF REGISTRATION**

STATE OF OREGON } ss.  
County of Marion

This is to certify that the foregoing Registration Statement was received in the office of the State Engineer on the 23rd day of March, 1956, at 8 o'clock A.M. and has been duly recorded in said office in Book No. 1 of Registration Statements on page GR-112 C.

~~Construction shall be completed by October 19, 1956 and the water completely applied to beneficial use by October 19, 1956.~~

Witness my hand this 8th day of October, 1956.

Lewis A. Stanley  
(State Engineer)

By \_\_\_\_\_ (Deputy)

GR-142 C