

RECEIVED  
APR 21 1958

Registration No. GR - 1491

Certificate No. GR - 1441

STATE ENGINEER  
SALEM, OREGON

# Registration Statement

## OF CLAIMANT OF RIGHT TO APPROPRIATE GROUND WATER

TO THE STATE ENGINEER OF OREGON:

I, W E Watson

of Rt 2 Box 115 Springfield Lane  
(Mailing address) County of Lane

State of Oregon, do hereby make application for a certificate of registration as evidence of a right to appropriate ground water.

1. Source from which water is withdrawn is Pump well #1  
(Flowing well, pump well, infiltration trench, or tunnel)

2. Location is: Nine mile east of Springfield  
(Approximate distance and direction from nearest city or town)

and is more particularly described as follows:

(a) 1389 ft. S. & 822 ft. E. of NW Cor. Sec. 32  
(Give distance and bearing to corner of section or other legal subdivision)

being within SW/4 NW of Sec. 32, Twp. 17 S, Rge. 1 W  
(Smallest legal subdivision) (N. or S.) (E. or W.)

or (b) within limits of recorded platted property, town or city:

in Lot \_\_\_\_\_, Block \_\_\_\_\_ of \_\_\_\_\_  
(Name of plat or addition)

(If within city or town, give name) County of \_\_\_\_\_

3. Construction Work was begun on Aug 17, 1925, was completed on April 1952  
(Date) (Date)

and the ground water claimed was first used for the purposes set out below on Aug 25, 1925  
(Date)

since which time the water has been used Intermittently  
(Continuously or intermittently)

from Aug 25, 1925 to Aug 15, 1957 or present  
(Date) (Date)

4. Quantity of water claimed and used is 200 gallons per minute; 38.8 acre feet per year.

5. Purpose or Purposes for which water is used Irrigation

(Domestic, irrigation, municipal, manufacturing, industrial, etc.)

6. Description of Well: Depth 15 feet. Type Driven  
(Dug or drilled)

diameter four inches. Elevation of ground at well site 500 feet, mean sea level.  
(As near as known)

Depth to water table 10 feet.

7. Capacity of Well: \_\_\_\_\_ g.p.m. with X feet drawdown.

\_\_\_\_\_ g.p.m. with \_\_\_\_\_ feet drawdown.

Date of test Not tested

If Flowing Well: Measured discharge \_\_\_\_\_ g.p.m. on \_\_\_\_\_  
(Date)


Shut-in pressure at ground surface \_\_\_\_\_ lbs. per sq. in. on \_\_\_\_\_  
(Date)

Water is controlled by \_\_\_\_\_  
(Cap, valve, etc.)





Township 17 S Range 1 W, W.M.  
North

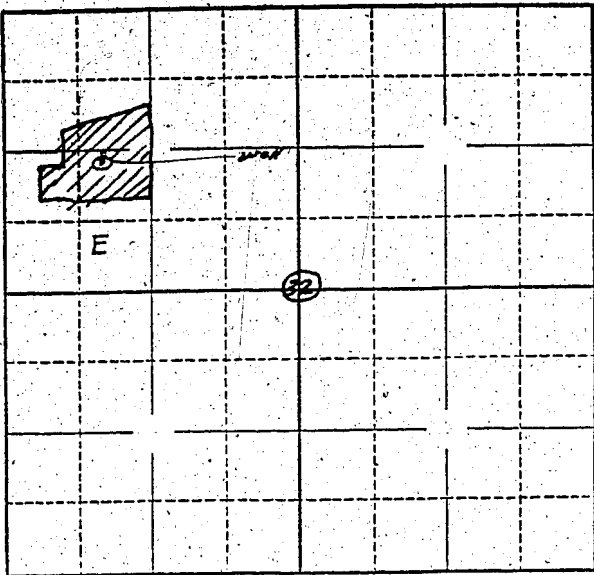

Locate well and acreage of irrigated land on plat.  
Scale: 2" = 1 Mile

STATE OF OREGON

County of Marion

} ss.

I, \_\_\_\_\_, being first duly sworn, do hereby certify that I have read the foregoing Registration Statement and that all of the items therein contained are true to the best of my knowledge and belief.

H. E. Haden

(Signature of Registrant)

Subscribed and sworn to before me this 1st day of April, 1958

My commission expires 12th June 1961

Wm. S. Bartholomew

(Notary Public)

(SEAL)

**CERTIFICATE OF REGISTRATION**

STATE OF OREGON

County of Marion

} ss.

This is to certify that the foregoing Registration Statement was received in the office of the State Engineer on the 23rd day of April, 1958, at 8:00 o'clock A. M. and has been duly recorded in said office in Book No. 7 of Registration Statements on page GR-1441

Witness my hand this 1st day of December, 1958

Leura A. Stanley

(State Engineer)

By \_\_\_\_\_

(Deputy)

GR - 1441