

RECEIVED
APR 27 1958
STATE ENGINEER
SALEM, OREGON

Registration Statement

OF CLAIMANT OF RIGHT TO APPROPRIATE GROUND WATER

TO THE STATE ENGINEER OF OREGON:

I, Alice G. Flanigan, Recorder for Town of Lafayette

of P. O. Box 136, Lafayette, Oregon County of Yamhill

(Mailing address)

State of Oregon, do hereby make application for a certificate of registration as evidence of a right to appropriate ground water.

1. Source from which water is withdrawn is One Pump Well #1

(Flowing well, pump well, infiltration trench, or tunnel)

2. Location is:

(Approximate distance and direction from nearest city or town)

and is more particularly described as follows:

(a) 850 Ft. N. and 650 Ft. E. from the SW Corner of Sec. 6

(Give distance and bearing to corner of section or other legal subdivision)

being within SW¹ SW² of Sec. 6, Twp. 4S, Rge. 4W

(Smallest legal subdivision)

(N, or S.)

(E. or W.)

or (b) within limits of recorded platted property, town or city: Lafayette

in Lot City Park Block of Lafayette original townsite

(Name of plat or addition)

County of Yamhill

(If within city or town, give name)

3. Construction Work was begun on 1915; was completed on 1949

(Date)

(Date)

and the ground water claimed was first used for the purposes set out below on 1949

(Date)

since which time the water has been used continuously

(Continuously or intermittently)

from 1949 to Oct. 1957

(Date)

(Date)

4. Quantity of water claimed and used is 200 gallons per minute; _____ acre feet per year.

5. Purpose or Purposes for which water is used Municipal uses

(Domestic, irrigation, municipal, manufacturing, industrial, etc.)

6. Description of Well: Depth 240 feet. Type Drilled

(Dug or drilled)

diameter 10 inches. Elevation of ground at well site _____ feet, mean sea level.

(As near as known)

Depth to water table 70 feet.

7. Capacity of Well: 330 g.p.m. with 40 feet drawdown.

_____ g.p.m. with _____ feet drawdown.

Date of test Sept. 1957

If Flowing Well: Measured discharge _____ g.p.m. on _____

(Date)

Shut-in pressure at ground surface _____ lbs. per sq. in. on _____


(Date)

Water is controlled by _____

(Cap, valve, etc.)

Township 18S Range 3 & 4 W, W.M.

North

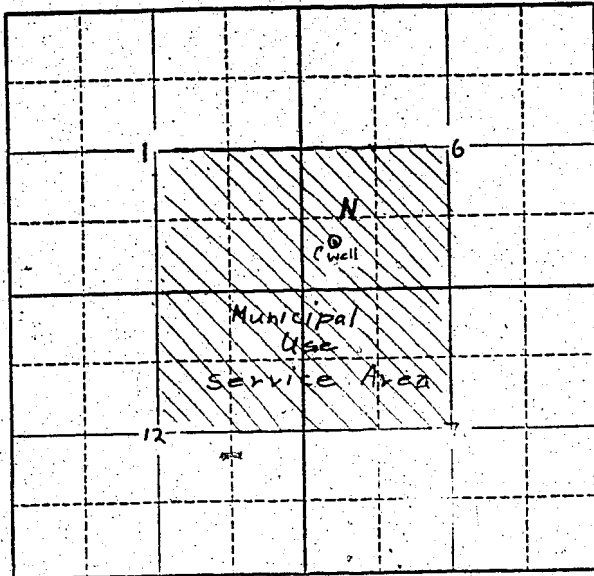

Locate well and acreage of irrigated land on plat.

Scale: 2" = 1 Mile

STATE OF OREGON

County of Yamhill

ss.

I, Alice G. Flanigan, being first duly sworn, do hereby certify that I have read the foregoing Registration Statement and that all of the items therein contained are true to the best of my knowledge and belief.

Alice G. Flanigan
(Signature of Registrant)

Subscribed and sworn to before me this 9 day of April, 1958.

My commission expires Dec 16 - 1960

C. E. Lewis
(Notary Public)

(SEAL)

CERTIFICATE OF REGISTRATION

STATE OF OREGON

County of Marion

ss.

This is to certify that the foregoing Registration Statement was received in the office of the State Engineer on the 30th day of April, 1958, at 1:00 o'clock P.M. and has been duly recorded in said office in Book No. 7 of Registration Statements on page GR-1442

Witness my hand this 1st day of December, 1958.

Lewis A. Stanley
(State Engineer)

By _____
(Deputy)