

Registration Statement

OF CLAIMANT OF RIGHT TO APPROPRIATE GROUND WATER

TO THE STATE ENGINEER OF OREGON:

I, Lloyd L. Lind
of Rt. 1, Box 605, Salem, Ore County of Yamhill
(Mailing address)

State of Oregon, do hereby make application for a certificate of registration as evidence of a right to appropriate ground water.

1. Source from which water is withdrawn is Pump Well # 1
(Flowing well, pump well, infiltration trench, or tunnel)

2. Location is: 10 mi. N. of West Salem, Oregon
(Approximate distance and direction from nearest city or town)

and is more particularly described as follows: From SW. Corner Wm Miller D.L.C. #59, well is

(a) N 89° 25' E - 25.68 ch., thence N 9° E - 26.007 ch., thence East 66.441 chains
(Give distance and bearing to corner of section or other legal subdivision)

being within NW 1/4 NW 1/4 of Sec. 4, Twp. 6 S, Rge. 3 W
(Smallest legal subdivision) (N. or S.) (E. or W.)

or (b) within limits of recorded platted property, town or city:

in Lot _____, Block _____ of _____
(Name of plat or addition)

County of _____
(If within city or town, give name)

3. Construction Work was begun on June 1947; was completed on June 1947
(Date) (Date)

and the ground water claimed was first used for the purposes set out below on June 1947
(Date)

since which time the water has been used Intermittently for irrigation
(Continuously or intermittently)

from May 1 to Sept. 20
(Date) (Date)

4. Quantity of water claimed and used is 60 gallons per minute; _____ acre feet per year.

5. Purpose or Purposes for which water is used, irrigation

(Domestic, irrigation, municipal, manufacturing, industrial, etc.)

6. Description of Well: Depth 84 feet. Type Drilled
(Dug or drilled)

diameter 6 inches. Elevation of ground at well site _____ feet, mean sea level.
(As near as known)

Depth to water table 48 feet.
No test

7. Capacity of Well: _____ g.p.m. with _____ feet drawdown.

_____ g.p.m. with _____ feet drawdown.

Date of test _____

If Flowing Well: Measured discharge _____ g.p.m. on _____
(Date)

Shut-in pressure at ground surface _____ lbs. per sq. in. on _____
(Date)

Water is controlled by _____
(Cap, valve, etc.)

8. Casing: (Give diameter, commercial specifications and depth below ground surface of each casing size.)

6 inch diameter from 1' to 84' feet
 inch diameter from to feet
 inch diameter from to feet
 inch diameter from to feet

Describe and show depth of shoe, plug, adapter, liner or other details:

9. Perforated Casings or Screens:

No perforations from to
(Number per foot and size of perforations, or describe screen)
 from to
 from to
 from to

10. Log of Well: (Describe each stratum or formation clearly, indicate if water bearing, and give thickness and depth as indicated.)

MATERIAL	Thickness (Feet)	Depth to Bottom (Feet)
Surface	3	3
Gray sandy clay	20	23
Sand	57	80
Sand & gravel	4	84

If log of well is not available, give name and address of driller. John T. Miller
Aurora, Ore.

11. Infiltration Trench: Covered or open _____
 Dimensions: Length _____ ft. Minimum depth _____ ft. Maximum depth _____ ft.
 Bottom width _____ ft. Discharge _____ g.p.m. Date of test _____
12. Tunnel: Type of lining _____
 Dimensions: _____
(Length, course, and cross sectional size)
 Position of water bearing stratum with reference to portal of tunnel _____

Log of tunnel: (Preceding table for log of well may be used, if desired. Give footage from portal and character of materials, as pertinent.)

13. Pumping Equipment:
 (a) Pump Jasuzi jet S.H.P. Capacity 60 g.p.m.
(Make, type and size)
 (b) Motor Vertical S.H.P.
(Type and horsepower)


14. Location of area irrigated or to be irrigated, or place of use if for purposes other than irrigation.

Township North or South	Range E. or W. of Willamette Meridian	Section	Forty-acre Tract	Number Acres To Be Irrigated	Date of Reclamation
5 S.	3 W.	32	SE 1/4 of SE 1/4	12	1947
-	"	33	SW 1/4 of SW 1/4	33	1947
6 S.	"	4	NW 1/4 of NW 1/4	17	1947
-	"	5	NE 1/4 of NE 1/4	25	1947
				87	

15. If the ground water supply is supplemental to an existing water supply, identification of any application for a permit, permit, certificate or adjudicated right to appropriate water made or held by the registrant.
None.

Map shown on claim for well # 2.

Township 6S Range 3W, W.M.
North

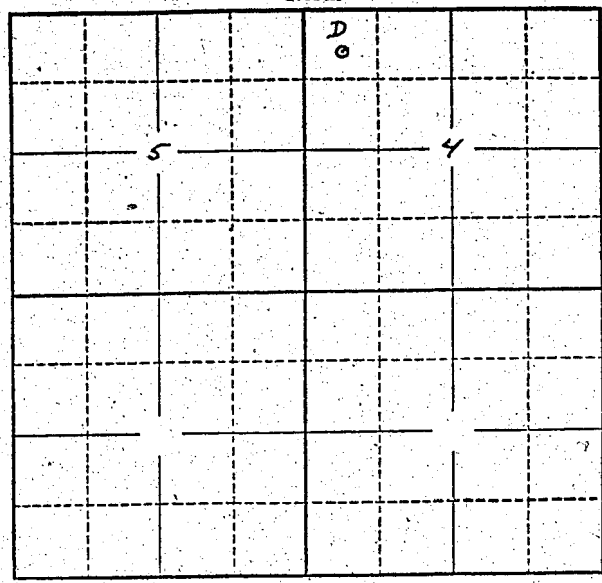

Locate well and acreage of irrigated land on plat.
Scale: 2" = 1 Mile

STATE OF OREGON }
County of _____ } ss.

_____, being first duly sworn, do hereby certify that I have read the foregoing Registration Statement and that all of the items therein contained are true to the best of my knowledge and belief.

Lloyd L. Lind
(Signature of Registrant)

Subscribed and ^{affirmed} sworn to before me this 24 day of April, 1958.

My commission expires September 8, 1960

Mar. Rogers
(Notary Public)

(SEAL)

CERTIFICATE OF REGISTRATION

STATE OF OREGON }
County of Marion } ss.

This is to certify that the foregoing Registration Statement was received in the office of the State Engineer on the 24th day of April, 1958, at 8⁰⁰ o'clock A. M. and has been duly recorded in said office in Book No. 7 of Registration Statements on page GR-1447

Witness my hand this 1st day of December, 1958

Laura A. Stanley
(State Engineer)

By _____
(Deputy)

GR - 1447