

Registration Statement

OF CLAIMANT OF RIGHT TO APPROPRIATE GROUND WATER

TO THE STATE ENGINEER OF OREGON:

I, Paul E. Riegelmann & Ethel May Riegelmann
of Rt 1, Box 248, West Linn, Oregon county of _____
(Mailing address)

State of _____, do hereby make application for a certificate of registration as evidence of a right to appropriate ground water.

- 1. Source from which water is withdrawn is Pump Well #1
(Flowing well, pump well, infiltration trench, or tunnel)
- 2. Location is: 3 miles SW of Oswego, Oregon
(Approximate distance and direction from nearest city or town)

and is more particularly described as follows:

(a) 300 feet east & 200 feet north from SW corner Section 21
(Give distance and bearing to corner of section or other legal subdivision)
being within SW 1/4 of SW 1/4 of Sec. 21, Twp. 2S, Rge. 1E
(Smallest legal subdivision) (or S.) (or W.)

or (b) within limits of recorded platted property, town or city:
in Lot _____, Block _____ of _____
(Name of plat or addition)

County of _____
(If within city or town, give name)

3. Construction Work was begun on Aug. 19, 1946; was completed on Aug. 1946
(Date) (Date)
and the ground water claimed was first used for the purposes set out below on Sept. 1946
(Date)
since which time the water has been used intermittently during season
(Continuously or Intermittently)
from Aug 1946 to Oct. 1957
(Date) (Date)

4. Quantity of water claimed and used is 25 gallons per minute; _____ acre feet per year.

5. Purpose or Purposes for which water is used Irrigation
(Domestic, irrigation, municipal, manufacturing, industrial, etc.)

6. Description of Well: Depth 330 feet. Type Drilled
(Dug or drilled)
diameter 6 inches. Elevation of ground at well site 185 feet, mean sea level.
(As near as known)
Depth to water table 40 feet.

7. Capacity of Well: 15 g.p.m. with 110 feet drawdown.
10 g.p.m. with 80 feet drawdown.
25 g.p.m. with 160 feet drawdown.


Date of test _____

If Flowing Well: Measured discharge _____ g.p.m. on _____
(Date)

Shut-in pressure at ground surface _____ lbs. per sq. in. on _____
(Date)

Water is controlled by _____
(Cap, valve, etc.)

Township 25 Range 1E, W.M.
North

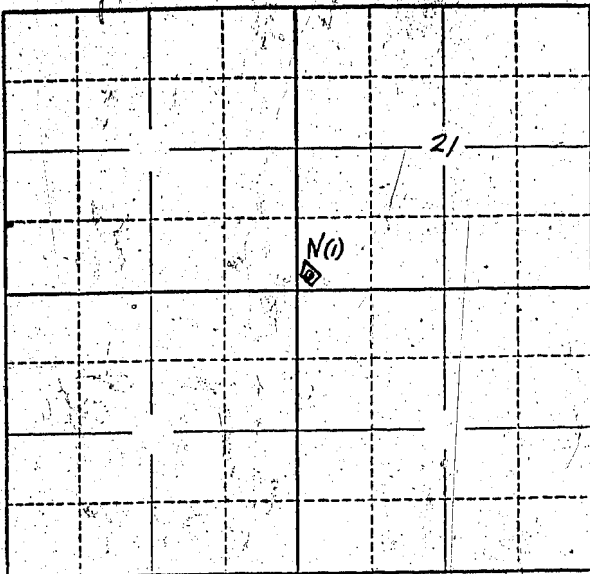

Locate well and acreage of irrigated land on plat.
Scale: 2" = 1 Mile

STATE OF OREGON

County of Marion

} ss.

I, _____, being first duly sworn, do hereby certify that I have read the foregoing Registration Statement and that all of the items therein contained are true to the best of my knowledge and belief.

Paul P. Chapman & Ethel May Chapman
(Signatures of Registrants)

Subscribed and sworn to before me this 25th day of April, 1958.

My commission expires 12th June 1961

Wm. S. Bartholomew
(Notary Public)

(SEAL)

CERTIFICATE OF REGISTRATION

STATE OF OREGON

County of Marion

} ss.

This is to certify that the foregoing Registration Statement was received in the office of the State Engineer on the 25th day of April, 1958, at 10⁰⁰ o'clock A. M. and has been duly recorded in said office in Book No. 7 of Registration Statements on page GR- 1452

Witness my hand this 1st day of December, 1958

Lewis A. Atkinson
(State Engineer)

By _____
(Deputy)