

RECEIVED  
APR 1 1954  
STATE ENGINEER  
SALEM, OREGON

Registration No. GR 1502

Certificate No. GR 1454

# Registration Statement

## OF CLAIMANT OF RIGHT TO APPROPRIATE GROUND WATER

TO THE STATE ENGINEER OF OREGON:

I, Gale Burkhart

of Rt. 2, Box 232, Lebanon County of Linn

State of Oregon, do hereby make application for a certificate of registration as evidence of a right to appropriate ground water.

1. Source from which water is withdrawn is Pump well No. 1  
(Flowing well, pump well, infiltration trench, or tunnel)

2. Location is: 5 miles north of Lebanon, Oregon  
(Approximate distance and direction from nearest city or town)

and is more particularly described as follows:

(a) S. 84° 40' E. 18.5 chains from NW corner of S. 22, T. 11 S., R. 2 W.W.M.  
(Give distance and bearing to corner of section or other legal subdivision)

being within NW 1/4 of NW 1/4 of Sec. 22, Twp. 11 S, Rge. 2 W  
(Smallest legal subdivision) (N. or S.) (E. or W.)

or (b) within limits of recorded platted property, town or city:

in Lot \_\_\_\_\_, Block \_\_\_\_\_ of \_\_\_\_\_  
(Name of plat or addition)

County of Linn  
(If within city or town, give name)

3. Construction Work was begun on Aug. 1954; was completed on Aug. 1954  
(Date) (Date)

and the ground water claimed was first used for the purposes set out below on Aug. 1954  
(Date)

since which time the water has been used continuously  
(Continuously or Intermittently)

from Aug. 1954 to present time  
(Date) (Date)

4. Quantity of water claimed and used is 300 gallons per minute; 211.5 acre feet per year.

5. Purpose or Purposes for which water is used Irrigation

(Domestic, irrigation, municipal, manufacturing, industrial, etc.)

6. Description of Well: Depth 20 feet. Type Drilled  
(Dug or drilled)

diameter 10 inches. Elevation of ground at well site 285 feet, mean sea level.  
(As near as known)

Depth to water table 12 feet.

7. Capacity of Well: 600 g.p.m. with 3 feet drawdown.

\_\_\_\_\_ g.p.m. with \_\_\_\_\_ feet drawdown.

Date of test Aug. 1954

If Flowing Well: Measured discharge \_\_\_\_\_ g.p.m. on \_\_\_\_\_  
(Date)

Shut-in pressure at ground surface \_\_\_\_\_ lbs. per sq. in. on \_\_\_\_\_  
(Date)

Water is controlled by \_\_\_\_\_  
(Cap, valve, etc.)

8. **Casing:** (Give diameter, commercial specifications and depth below ground surface of each casing size.)

10 inch diameter steel casing from 0 to 20 feet  
..... inch diameter ..... from ..... to ..... feet  
..... inch diameter ..... from ..... to ..... feet  
..... inch diameter ..... from ..... to ..... feet

Describe and show depth of shoe, plug, adapter, liner or other details:  
.....  
.....

**9. Perforated Casings or Screens:**

Slot perforations from 10 to 20  
(Number per foot and size of perforations, or describe screen)  
..... from ..... to .....  
..... from ..... to .....  
..... from ..... to .....

10. **Log of Well:** (Describe each stratum or formation clearly, indicate if water bearing, and give thickness and depth as indicated.)

MATERIAL	Thickness (feet)	Depth to Bottom (feet)
Not available		

If log of well is not available, give name and address of driller. Bill Hamilton Drilling Co.,

838 East Third Avenue, Albany, Oregon

11. Infiltration Trench: Covered or open \_\_\_\_\_

Dimensions: Length \_\_\_\_\_ ft. Minimum depth \_\_\_\_\_ ft. Maximum depth \_\_\_\_\_ ft.

Bottom width \_\_\_\_\_ ft. Discharge \_\_\_\_\_ g.p.m. Date of test \_\_\_\_\_

12. Tunnel: Type of lining \_\_\_\_\_

Dimensions: \_\_\_\_\_  
(Length, course, and cross sectional size)

Position of water bearing stratum with reference to portal of tunnel \_\_\_\_\_

Log of tunnel: (Preceding table for log of well may be used, if desired. Give footage from portal and character of materials, as pertinent.)

13. Pumping Equipment:

(a) Pump 2" centrifugal Capacity 300 g.p.m.  
(Make, type and size)

(b) Motor 15 H. P. electric  
(Type and horsepower)

14. Location of area irrigated or to be irrigated, or place of use if for purposes other than irrigation.

Township North or South	Range E. or W. of Willamette Meridian	Section	Forty-acre Tract	Number Acres To Be Irrigated	Date of Reclamation
11 S	2 W	15	SW $\frac{1}{4}$ of SW $\frac{1}{4}$	5.1	Aug. 1954
11 S	2 W	15	SE $\frac{1}{4}$ of SW $\frac{1}{4}$	13.0	Aug. 1954
11 S	2 W	15	SW $\frac{1}{4}$ of SE $\frac{1}{4}$	3.7	Aug. 1954
11 S	2 W	22	NW $\frac{1}{4}$ of NE $\frac{1}{4}$	9.0	Aug. 1954
11 S	2 W	22	NE $\frac{1}{4}$ of NW $\frac{1}{4}$	22.4	Aug. 1954
11 S	2 W	22	NW $\frac{1}{4}$ of NW $\frac{1}{4}$	7.0	Aug. 1954
11 S	2 W	15	SW $\frac{1}{4}$ of SW $\frac{1}{4}$	0.7	Aug. 1954
11 S	2 W	15	SE $\frac{1}{4}$ of SW $\frac{1}{4}$	16.4	Aug. 1954
11 S	2 W	15	NE $\frac{1}{4}$ of SW $\frac{1}{4}$	6.8	Aug. 1954
11 S	2 W	15	NW $\frac{1}{4}$ of SE $\frac{1}{4}$	0.5	Aug. 1954
				<u>84.6</u>	


Gale Burkhart, 46-276

Beginning at a point on the North line of the D.L.C. of Jonathan Wassom and wife, Not. No. 1186, Claim 49, T. 11 S., R. 2 W. of the Will. Mer. in Linn County, Oregon; which is 11.85 chains East of the Northwest corner of said Claim; thence East 33.78 chains; thence South 40.64 chains; thence West 40.61 chains; thence North 11.68 chains; thence East 30 links; thence North 17.18 chains; thence East 6.75 chains; thence North 11.85 chains to the place of beginning, containing 156.80 acres, more or less, in Linn County, Oregon, saving and excepting two acres heretofore conveyed by George F. Burkhart and wife to Ralph Chling by deed recorded at page 508 of Vol. 93 of the Deed records of Linn County, Oregon.

Ex. 93-508

Beginning at a point 11.85 chains East and 11.85 chains South of the Northwest corner of the D.L.C. of Jonathan Wassom and wife, Not. No. 1186 and Claim No. 49, T. 11 S., R. 2 W. of the Will. Mer.; and running thence South 2.96 chains; thence West 6.75 chains; thence North 2.96 chains; thence East 6.75 chains to the place of beginning, containing 2 acres, all situated in Linn County, State of Oregon, saving and excepting from this conveyance the rights granted to Edward Myers for a right of way along and over the West end of the above described premises, as described in a certain deed executed Jan. 16, 1904, and recorded on page 287 of Vol. 80 of the records of Deeds of Linn County, Oregon.

Township 11 S Range 2 W, W.M.  
North

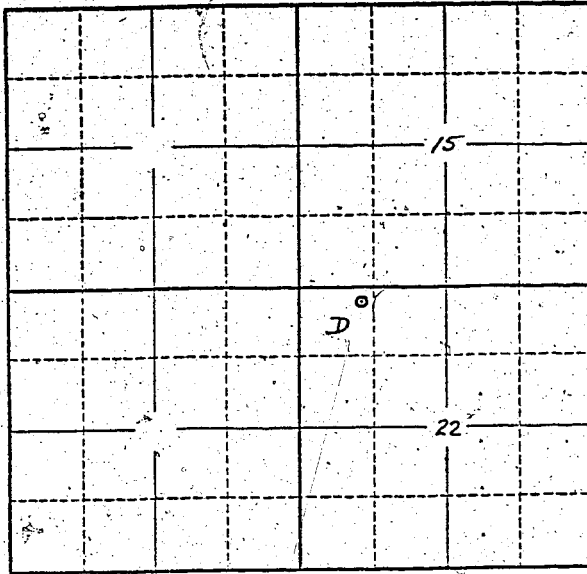

Locate well and acreage of irrigated land on plat.  
Scale: 2" = 1 Mile

STATE OF OREGON

County of LINN

} ss.

I, GALE BURKHART, being first duly sworn, do hereby certify that I have read the foregoing Registration Statement and that all of the items therein contained are true to the best of my knowledge and belief.

Gale Burkhart  
(Signature of Registrant)

Subscribed and sworn to before me this 23 day of April, 1958

My commission expires \_\_\_\_\_  
(Notary Public)

(SEAL)

**CERTIFICATE OF REGISTRATION**

STATE OF OREGON

County of Marion

} ss.

This is to certify that the foregoing Registration Statement was received in the office of the State Engineer on the 25<sup>th</sup> day of April, 1958, at 8:00 o'clock A.M. and has been duly recorded in said office in Book No. 7 of Registration Statements on page GR-1454

Witness my hand this 1st day of December, 1958

Lewis A. Stanley  
(State Engineer)

By \_\_\_\_\_  
(Deputy)

#2325