

RECEIVED  
STATE ENGINEER  
SALE OF GROUND WATER

Registration No. GR 1507

Certificate No. GR 1455

# Registration Statement

## OF CLAIMANT OF RIGHT TO APPROPRIATE GROUND WATER

TO THE STATE ENGINEER OF OREGON:

I, Donald Lee King

of 951 7th St Independence, Oregon County of Polk  
(Mailing address)

State of Oregon, do hereby make application for a certificate of registration as evidence of a right to appropriate ground water.

- Source from which water is withdrawn is pump well #1  
(Flowing well, pump well, infiltration trench, or tunnel)
- Location is: 1/2 mile from Independence  
(Approximate distance and direction from nearest city or town)

and is more particularly described as follows:

(a) N 7° E 720' FROM THE SW CORNER SEC 28  
(Give distance and bearing to corner of section or other legal subdivision)

being within SW/5W of Sec. 28, Twp. 8S, Rge. 4W  
(Smallest legal subdivision) (N. or S.) (E. or W.)

or (b) within limits of recorded platted property, town or city:

in Lot \_\_\_\_\_, Block \_\_\_\_\_ of \_\_\_\_\_  
(Name of plat or addition)

County of \_\_\_\_\_  
(If within city or town, give name)

3. Construction Work was begun on August 1951; was completed on August 1951  
(Date) (Date)

and the ground water claimed was first used for the purposes set out below on May 5 - 1952  
(Date)

since which time the water has been used intermittently only in summer  
(Continuous or intermittently)

from spring 1952 to fall 1957  
(Date) (Date)

4. Quantity of water claimed and used is 300 gallons per minute; 75 acre feet per year.

5. Purpose or Purposes for which water is used irrigate crops & pasture

(Domestic, irrigation, municipal, manufacturing, industrial, etc.)

6. Description of Well: Depth 64 feet. Type Drilled  
(Dug or drilled)

diameter 12 inches. Elevation of ground at well site Unknown feet, mean sea level.  
(As near as known)

Depth to water table 18 feet.

7. Capacity of Well: 450+ g.p.m. with 38 feet drawdown.

\_\_\_\_\_ g.p.m. with \_\_\_\_\_ feet drawdown.

Date of test August 1951

If Flowing Well: Measured discharge \_\_\_\_\_ g.p.m. on \_\_\_\_\_  
(Date)

Shut-in pressure at ground surface \_\_\_\_\_ lbs. per sq. in. on \_\_\_\_\_  
(Date)

Water is controlled by \_\_\_\_\_  
(Cap, valve, etc.)

8. Casing: (Give diameter, commercial specifications and depth below ground surface of each casing size.)

12 inch diameter *steel casing* from 0 to 6.9 feet  
inch diameter from to feet  
inch diameter from to feet  
inch diameter from to feet

Describe and show depth of shoe, plug, adapter, liner or other details:  
.....  
.....

9. Perforated Casings or Screens:

*Tersch Co. slots 2 per ft.* from 36' to 69'  
(Number per foot and size of perforations, or describe screen)  
from to  
from to  
from to

10. Log of Well: (Describe each stratum or formation clearly, indicate if water bearing, and give thickness and depth as indicated.)

*Underground*

MATERIAL	Thickness (Feet)	Depth to Bottom (Feet)

If log of well is not available, give name and address of driller. Art Clinton

Main St. Independence, Oregon

11. Infiltration Trench: Covered or open \_\_\_\_\_

Dimensions: Length \_\_\_\_\_ ft. Minimum depth \_\_\_\_\_ ft. Maximum depth \_\_\_\_\_ ft.

Bottom width \_\_\_\_\_ ft. Discharge \_\_\_\_\_ g.p.m. Date of test \_\_\_\_\_

12. Tunnel: Type of lining \_\_\_\_\_

Dimensions: \_\_\_\_\_  
(Length, course, and cross sectional size)

Position of water bearing stratum with reference to portal of tunnel \_\_\_\_\_

Log of tunnel: (Preceding table for log of well may be used, if desired. Give footage from portal and character of materials, as pertinent.)

13. Pumping Equipment:

(a) Pump Berkely Turbin 7.5 BHP Capacity 300 g.p.m.  
(Make, type and size)


(b) Motor General Electric 7.5  
(Type and horsepower)

14. Location of area irrigated or to be irrigated, or place of use if for purposes other than irrigation.

Township North or South	Range E. or W. of Willamette Meridian	Section	Forty-acre Tract	Number Acres To Be Irrigated	Date of Reclamation
8-5	4W	29	NE/SE	2.6	May 1952
"	"	29	SE/SE	16.4	"
"	"	28	<del>SW</del> /SW	11.7	"
"	"	32	NE/NE	4.0	"
"	"	33	NW/NW	1.2	"
				35.9 Ac	"

15. If the ground water supply is supplemental to an existing water supply, identification of any application for a permit, permit, certificate or adjudicated right to appropriate water made or held by the registrant.

Township 8S Range 4W W.M.  
North

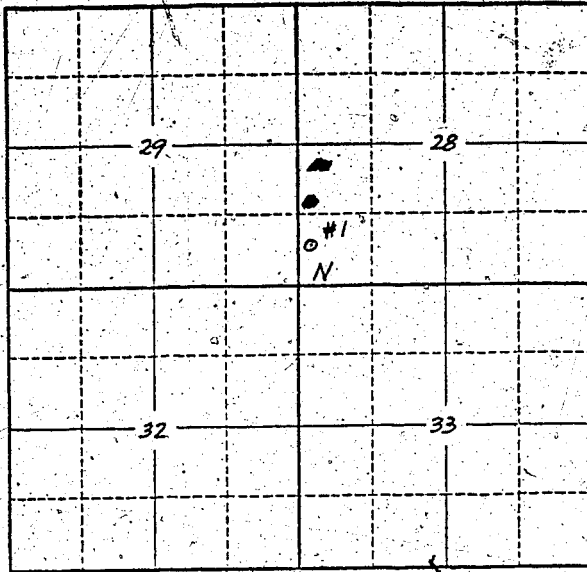

Locate well and acreage of irrigated land on plat.  
Scale: 2" = 1 Mile

STATE OF OREGON

County of Marion } ss.

I, \_\_\_\_\_ being first duly sworn, do hereby certify that I have read the foregoing Registration/Statement and that all of the items therein contained are true to the best of my knowledge and belief.

Donald Lee King  
(Signature of Registrant)

Subscribed and sworn to before me this 25th day of March, 1958

My commission expires 12th June 1961 Wm. S. Bartholomew  
(Notary Public)

(SEAL)

**CERTIFICATE OF REGISTRATION**

STATE OF OREGON

County of Marion } ss.

This is to certify that the foregoing Registration Statement was received in the office of the State Engineer on the 25th day of April, 1958, at 6:00 o'clock A. M. and has been duly recorded in said office in Book No. 7 of Registration Statements on page GR-1455

Witness my hand this 1st day of December, 1958

Lewis A. Atkinson  
(State Engineer)

By \_\_\_\_\_ (Deputy)

GR - 1455

#15.20