

RECEIVED  
APR 20 1956  
STATE ENGINEER  
SALES, OREGON

Registration No. GR - 1508  
Certificate No. GR - 1456

# Registration Statement

## OF CLAIMANT OF RIGHT TO APPROPRIATE GROUND WATER

TO THE STATE ENGINEER OF OREGON:

I, Ralph Plaisted

of Rt. 1, Box 594, Cottage Grove County of Lane

State of Oregon, do hereby make application for a certificate of registration as evidence of a right to appropriate ground water.

1. Source from which water is withdrawn is pump well  
(Flowing well, pump well, infiltration trench, or tunnel)

2. Location is: about 2 mi. S. E. of Cottage Grove, Oregon  
(Approximate distance and direction from nearest city or town)

and is more particularly described as follows:

(a) 446 ft. north and 255 ft. west of quarter section corner <sup>E 1/4</sup>  
between sections 9 and 34 appearing to corner of section or other legal subdivision

being within S. E. quarter of Sec. 34, Twp. 20S, Rge. 3 west  
(Smallest legal subdivision) Wilhelmette Meridian

or, (b) within limits of recorded platted property, town or city:

in Lot \_\_\_\_\_, Block \_\_\_\_\_ of \_\_\_\_\_  
(Name of plat or addition)

County of \_\_\_\_\_  
(If within city or town, give name)

3. Construction Work was begun on Aug. 1, 1955; was completed on Aug. 10, 1955  
(Date) (Date)

and the ground water claimed was first used for the purposes set out below on May 25, 1956  
(Date)

since which time the water has been used intermittently  
(Continuously or Intermittently)

from May 25, 1956 to Sept. 30, 1956, MAY 25, 1957 TO SEPT. 30, 1957  
(Date) (Date)

4. Quantity of water claimed and used is 19.45 gallons per minute; 2 acre feet per year.

5. Purpose or Purposes for which water is used irrigation

(Domestic, irrigation, municipal, manufacturing, industrial, etc.)

6. Description of Well: Depth 9 feet. Type dug  
(Dug or drilled)

diameter 36 inches. Elevation of ground at well site 652 feet, mean sea level.  
(As near as known)

Depth to water table 5' 10 1/2" feet.

7. Capacity of Well: 8 1/2 g.p.m. with 1/3 feet drawdown.

\_\_\_\_\_ g.p.m. with \_\_\_\_\_ feet drawdown.

Date of test Aug. 10, 1955

If Flowing Well: Measured discharge \_\_\_\_\_ g.p.m. on \_\_\_\_\_  
(Date)


Shut-in pressure at ground surface \_\_\_\_\_ lbs. per sq. in. on \_\_\_\_\_  
(Date)

Water is controlled by \_\_\_\_\_  
(Cap, valve, etc.)





Township 205 Range 3W W.M.  
North

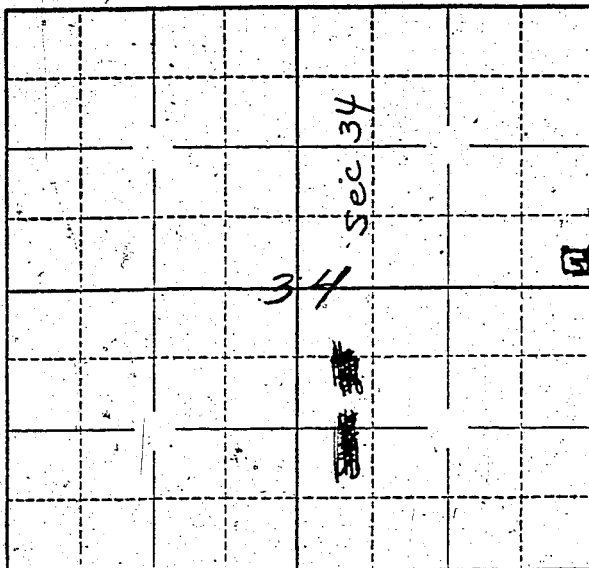

Locate well and acreage of irrigated land on plat.

Scale:  $\frac{1}{2}$ " = 1 Mile

STATE OF OREGON

County of Lane } ss.

I, Ralph Plaisted, being first duly sworn, do hereby certify that I have read the foregoing Registration Statement and that all of the items therein contained are true to the best of my knowledge and belief.

(Signature of Registrant)

Subscribed and sworn to before me this 22nd day of April, 1958

My commission expires May 10th 1961

(Notary Public)

(SEAL)

### CERTIFICATE OF REGISTRATION

STATE OF OREGON

County of Marion } ss.

This is to certify that the foregoing Registration Statement was received in the office of the State Engineer on the 25th day of April, 1958, at 8.00 o'clock A. M. and has been duly recorded in said office in Book No. 7 of Registration Statements on page GR-1456

Witness my hand this 1st day of December, 1958

*Laura A. Stanley*  
(State Engineer)

By \_\_\_\_\_

(Deputy)

GR - 1456

4/15.00