

Registration Statement

OF CLAIMANT OF RIGHT TO APPROPRIATE GROUND WATER

3

TO THE STATE ENGINEER OF OREGON:

I, E. Clemens Horst Co.,
of R.R. 1, Independence, Oregon County of Polk
(Mailing address)

State of Oregon, do hereby make application for a certificate of registration as evidence of a right to appropriate ground water.

1. Source from which water is withdrawn is Pump Well # 3
(Flowing well, pump well, infiltration trench, or tunnel)

2. Location is: 4 Miles, N.E. Independence, Ore.
(Approximate distance and direction from nearest city or town)

and is more particularly described as follows:

(a) 537° E - 1070 ft. from N.W. Corner Sec 11
(Give distance and bearing to corner of section or other legal subdivision)

being within NW 1/4 of NW 1/4 of Sec. 11, Twp. 8 S, Rge. 4 W
(Smallest legal subdivision) (N. or S.) (E. or W.)

or (b) within limits of recorded platted property, town or city:

in Lot _____, Block _____ of _____
(Name of plat or addition)

County of _____
(If within city or town, give name)

3. Construction Work was begun on 1910, was completed on 1910
(Date) (Date)

and the ground water claimed was first used for the purposes set out below on 1910
(Date)

since which time the water has been used Continuously intermittently
(Continuously or intermittently)

from June 1910 to Sept. 1957
(Date) (Date)

4. Quantity of water claimed and used is 800 gallons per minute; 338.8 acre feet per year.
~~311.8~~

5. Purpose or Purposes for which water is used Irrigation

(Domestic, irrigation, municipal, manufacturing, industrial, etc.)

6. Description of Well: Depth 50 feet. Type Drilled
(Dug or drilled)

diameter 8 inches. Elevation of ground at well site _____ feet, mean sea level.
(As near as known)

Depth to water table 20 feet.

7. Capacity of Well: 800 g.p.m. with 10' feet drawdown.

_____ g.p.m. with _____ feet drawdown.

Date of test ?

If Flowing Well: Measured discharge _____ g.p.m. on _____
(Date)

Shut-in pressure at ground surface _____ lbs. per sq. in. on _____
(Date)

Water is controlled by _____
(Cap, valve, etc.)

8. Casing: (Give diameter, commercial specifications and depth below ground surface of each casing size.)

8 inch diameter steel well casing from 1 to 50 feet
 inch diameter _____ from _____ to _____ feet
 inch diameter _____ from _____ to _____ feet
 inch diameter _____ from _____ to _____ feet

Describe and show depth of shoe, plug, adapter, liner or other details: _____

9. Perforated Casings or Screens:

Don't know
GR- with 20 mesh slots from _____ to _____
 (Number per foot and size of perforations, or describe screen)
 _____ from _____ to _____
 _____ from _____ to _____
 _____ from _____ to _____

10. Log of Well: (Describe each stratum or formation clearly, indicate if water bearing, and give thickness and depth as indicated.)

MATERIAL	Thickness (Feet)	Depth to Bottom (Feet)
Silt Loam	15	15
Clay Loam	10	25
Gravel	15	40

If log of well is not available, give name and address of driller.

11. Infiltration Trench: Covered or open

Dimensions: Length _____ ft. Minimum depth _____ ft. Maximum depth _____ ft.

Bottom width _____ ft. Discharge _____ g.p.m. Date of test _____

12. Tunnel: Type of lining

Dimensions: _____
(Length, course, and cross sectional size)

Position of water bearing stratum with reference to portal of tunnel _____

Log of tunnel: (Preceding table for log of well may be used, if desired) Give footage from portal and character of materials, as pertinent)

13. Pumping Equipment:

(a) Pump 5" x 6" centrifugal Capacity 800 g.p.m.
(Make, type and size)

(b) Motor 1.0 HP c/c
(Type and horsepower)


14. Location of area irrigated or to be irrigated, or place of use if for purposes other than irrigation.

Township North or South	Range E. or W. of Williamsburg Meridian	Section	Forty-acre tract	Number Acres To Be Irrigated	Date of Reclamation
8 S	4 W	11	SW 1/4 of NW 1/4	17.2	1910
8 S	4 W	11	SE 1/4 of NW 1/4	27.6	"
8 S	4 W	11	NN 1/4 of NW 1/4	48.0	"
8 S	4 W	11	NE 1/4 of NW 1/4	25.0	"
8 S	4 W	10	NE 1/4 of NE 1/4	21.3	"
8 S	4 W	10	SE 1/4 of NE 1/4	4.2	"
				135.5	

15. If the ground water supply is supplemental to an existing water supply; identification of any application for a permit, permit, certificate or adjudicated right to appropriate water made or held by the registrant.

Township 85 Range 4W W.M.

North

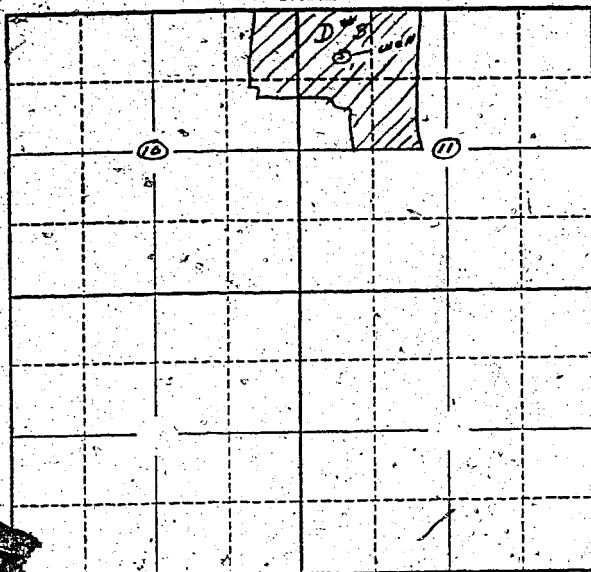

Locate well and acreage of irrigated land on plat.

Scale: 2" = 1 Mile.

STATE OF OREGON

County of Marion

I, E. L. MENNERS HORST being first duly sworn, do hereby certify that I have read the foregoing Registration Statement and that all of the items therein contained are true to the best of my knowledge and belief.

E. L. Menners Horst
(Signature of Registrant)

Subscribed and sworn to before me this 25th day of March, 19 58

My commission expires 12th June 1961 Wm. S. Bartholomew
(Notary Public)

(SEAL)

CERTIFICATE OF REGISTRATION

STATE OF OREGON

County of Marion

This is to certify that the foregoing Registration Statement was received in the office of the State Engineer on the 25th day of April, 19 58, at 9:30 o'clock A. M. and has been duly recorded in said office in Book No. 7 of Registration Statements on page GR-1460

Witness my hand this 1st day of December, 19 58

Lewis A. Stanley
(State Engineer)

By _____
(Deputy)

GR - 1460