

Registration Statement

OF CLAIMANT OF RIGHT TO APPROPRIATE GROUND WATER

DH

TO THE STATE ENGINEER OF OREGON:

I, D. F. Kennedy
of R.R. #1, Independence, Oregon County of Polk
State of Oregon, do hereby make application for a certificate of registration as evidence
of a right to appropriate ground water.

1. Source from which water is withdrawn is Pump Well
(Flowing well, pump well, infiltration trench, or tunnel)

2. Location is: 1 Mile South of Independence,
(Approximate distance and direction from nearest city or town)

and is more particularly described as follows:

(a) S 38° W - 1020 ft from NE. Cor. D.F. Burch D.L.C.
(Give distance and bearing to corner of section or other legal subdivision)

being within SW 1/4 of SE 1/4 of Sec. 33, Twp. 8 S, Rge. 4 W
(Smallest legal subdivision) (or of S.) (or of W.)

or (b) within limits of recorded platted property, town or city:

in Lot _____, Block _____ of _____
(If within city or town, give name) County of Polk
(Name of plat or addition)

3. Construction Work was begun on 1948, July; was completed on July 1948
(Date) (Date)

and the ground water claimed was first used for the purposes set out below on July 1948
(Date)

since which time the water has been used Intermittently
(Continuously or Intermittently)

from April 1948 to Sept. 1957
(Date) (Date)

4. Quantity of water claimed and used is 400 gallons per minute; 62.2 acre
feet per year.

5. Purpose or Purposes for which water is used Irrigation

(Domestic, irrigation, municipal, manufacturing, industrial, etc.)

6. Description of Well: Depth 40 feet. Type Drilled

(Dug or drilled)

diameter 12 inches. Elevation of ground at well site _____ feet, mean sea level.

(As near as known)

Depth to water table 16 feet.

7. Capacity of Well: 400 g.p.m. with 10 feet drawdown.

_____ g.p.m. with _____ feet drawdown.

Date of test None

If Flowing Well: Measured discharge _____ g.p.m. on _____
(Date)

Shut-in pressure at ground surface _____ lbs. per sq. in. on _____
(Date)

Water is controlled by _____
(Cap, valve, etc.)

8. **Casing:** (Give diameter, commercial specifications and depth below ground surface of each casing size.)

12	inch diameter	Steel Well Casing	from	1	to	40	feet
	inch diameter		from		to		feet
	inch diameter		from		to		feet
	inch diameter		from		to		feet

Describe and show depth of shoe, plug, adapter, liner or other details: _____

9. Perforated Casings or Screens:

Material	Quantity	Unit	Remarks
Cut with torch	30	to	40
(Number per foot and size of perforations, or describe screen)			
	from		to
	from		to
	from		to
	from		to

10. **Log of Well:** (Describe each stratum or formation clearly, indicate if water bearing, and give thickness and depth as indicated.)

[illegible]

If log of well is not available, give name and address of driller. R Arch Sloper

B. Arch Sloper

Indep

11. Infiltration Trench: Covered or open

Dimensions: Length ft. Minimum depth ft. Maximum depth ft.

Bottom width ft. Discharge g.p.m. Date of test

12. Tunnel: Type of lining

Dimensions: _____
(Length, course, and cross sectional size)

Position of water bearing stratum with reference to portal of tunnel

Log of tunnel: (Preceding table for log of well may be used, if desired. Give footage from portal and character of materials, as pertinent.)

13. Pumping Equipment:

(a) Pump CENTENNIAL 25 HP Capacity 200 g.p.m.
(Make, type and size)


(b) Motor 25HP. gasoline (Type and horsepower)

14. Location of area irrigated or to be irrigated, or place of use if for purposes other than irrigation.

[illegible]

15. If the ground water supply is supplemental to an existing water supply, identification of any application for a permit, permit, certificate or adjudicated right to appropriate water made or held by the registrant.

Township 8 S. Range 4 W. W.M.
North

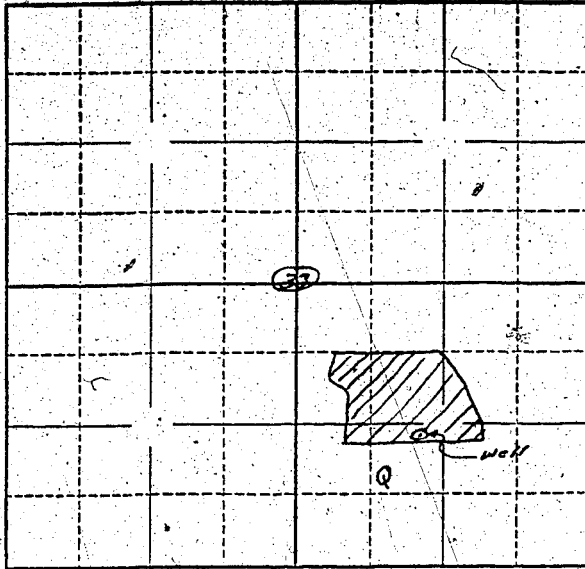

Locate well and acreage of irrigated land on plat.
Scale: 2" = 1 Mile

STATE OF OREGON

County of Polk

ss.

I, D. F. Kennedy, being first duly sworn, do hereby certify that I have read the foregoing Registration Statement and that all of the items therein contained are true to the best of my knowledge and belief.

D. F. Kennedy
(Signature of Registrant)

Subscribed and sworn to before me this 25th day of March, 1958

My commission expires 12th June 1961

Wm. S. Bartholmeis
(Notary Public)

(SEAL)

CERTIFICATE OF REGISTRATION

STATE OF OREGON

County of Marion

ss.

This is to certify that the foregoing Registration Statement was received in the office of the State Engineer on the 25th day of April, 1958, at 11:00 o'clock A.M. and has been duly recorded in said office in Book No. 7 of Registration Statements on page GR-1464

Witness my hand this 1st day of December, 1958

Leora A. Stanley
(State Engineer)

By

(Deputy)

GR-1464