

Registration Statement

OF CLAIMANT OF RIGHT TO APPROPRIATE GROUND WATER

RS

TO THE STATE ENGINEER OF OREGON:

I, D. E. Kennedy,
of R.R. 1, Independence, Oregon, County of _____
State of Oregon, do hereby make application for a certificate of registration as evidence
of a right to appropriate ground water.

1. Source from which water is withdrawn is Pump Well #1
(Flowing well, pump well, infiltration trench, or tunnel)

2. Location is: 6 Miles, N.W. of Salem, Oregon.
(Approximate distance and direction from nearest city or town)

and is more particularly described as follows:

(a) 1950 feet east & 75 feet south from NW corner Section 28
(Give distance and bearing to corner of section or other legal subdivision)
being within NE 1/4 of NW 1/4 of Sec. 28, Twp. 6-S, Rge. 3 W.W.M.
(Smallest legal subdivision) (N. or S.) (E. or W.)

or (b) within limits of recorded platted property, town or city: _____

in Lot _____, Block _____ of _____
(Name of plat or addition)
County of W.
(If within city or town, give name)

3. Construction Work was begun on 15 May, 1950; was completed on May 18, 1950
(Date) (Date)
and the ground water claimed was first used for the purposes set out below on May 20, 1950
(Date)
since which time the water has been used Intermittently
(Continuously or Intermittently)
from May to October
(Date) (Date)

4. Quantity of water claimed and used is 750 gallons per minute; _____ acre
feet per year.

5. Purpose or Purposes for which water is used Irrigation
(Domestic, irrigation, municipal, manufacturing, industrial, etc.)

6. Description of Well: Depth 35 Ft. feet. Type Drilled
(Dug or drilled)
diameter 12 inches. Elevation of ground at well site _____ feet, mean sea level.
(As near as known)
Depth to water table 12 feet.

7. Capacity of Well: 750 g.p.m. with 6 feet drawdown.
_____ g.p.m. with _____ feet drawdown.

Date of test None

If Flowing Well: Measured discharge _____ g.p.m. on _____
(Date)

Shut-in pressure at ground surface _____ lbs. per sq. in. on _____
(Date)

Water is controlled by _____
(Cap, valve, etc.)

8. Casing: (Give diameter, commercial specifications and depth below ground surface of each casing size.)

12 inch diameter Screw Casing from 0 to 32 feet
..... inch diameter from to feet
..... inch diameter from to feet
..... inch diameter from to feet

Describe and show depth of shoe, plug, adapter, liner or other details:
.....
.....


9. Perforated Casings or Screens:

Torch cutting from 17 to 32
(Number per foot and size of perforations, or describe screen)
..... from to
..... from to
..... from to

10. Log of Well: (Describe each stratum or formation clearly, indicate if water bearing, and give thickness and depth as indicated.)

MATERIAL	Thickness (Feet)	Depth to Bottom (Feet)
Sandy Loam	10 Ft.	
Sand and Gravel	7 "	
Gravel	15 "	

Township 65 Range 3w W.M.
North

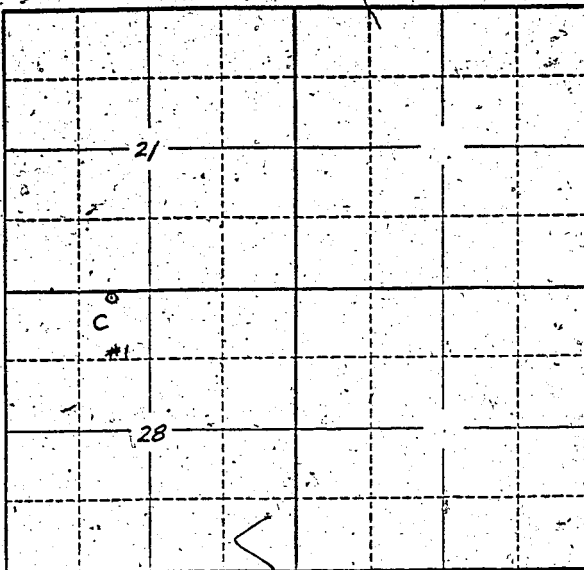

Locate well and acreage of irrigated land on plat.
Scale: 2" = 1 Mile

STATE OF OREGON

County of Marion

ss.

I, D. F. Kennedy, being first duly sworn, do hereby certify that I have read the foregoing Registration Statement and that all of the items therein contained are true to the best of my knowledge and belief.

D. F. Kennedy
(Signature of Registrant)

Subscribed and sworn to before me this 25th day of April, 1958

My commission expires 12th June 1961

Wm. S. Bartholomew
(Notary Public)

(SEAL)

CERTIFICATE OF REGISTRATION

STATE OF OREGON

County of Marion

ss.

This is to certify that the foregoing Registration Statement was received in the office of the State Engineer on the 25th day of April, 1958, at 11:30 o'clock A. M. and has been duly recorded in said office in Book No. 7 of Registration Statements on page GR-1465

Witness my hand this 1st day of December, 1958

Laura A. Stanton
(State Engineer)

By

(Deputy)

GR - 1465

#2220