

RECEIVED
MAR 30 1956
STATE ENGINEER
SALEM, OREGON

REGISTRATION NO. GR-152

Registration Statement

CERTIFICATE NO. GR/45

SALEM, OREGON CLAIMANT OF RIGHT TO APPROPRIATE GROUND WATER

(Under Chapter 708, Oregon Laws 1955.)

TO THE STATE ENGINEER OF OREGON:

I, HARVEY MACHINE CO. INC.,

of Salem County of Marion

State of Oregon, do hereby make application for a certificate of registration as evidence of a right to appropriate ground water.

1. Source from which water is withdrawn is pump well
(Flowing well, pump well, infiltration trench, or tunnel)

2. Location is: one-half mile north of Salem City Limits.
(Approximate distance and direction from nearest city or town).

and is more particularly described as follows:

(a) 440 feet S 20° 30' W from N.E. corner of S.W. Quarter
(Give distance and bearing to corner of section or other legal subdivision)
being within NE 1/4 of S.W. Quarter of Sec. 11, Twp. 7 S., Rge. 3 W.
(Smallest legal subdivision) (N. or S.) (E. or W.)

or (b) within limits of recorded platted property, town or city:
in Lot _____, Block _____ of _____
(Name of plat or addition)

County of _____
(If within city or town, give name)

3. Construction Work was begun on June, 1947; was completed on June, 1947
(Date) (Date)

and the ground water claimed was first used for the purposes set out below on June, 1947
(Date)

since which time the water has been used continuously
(Continuously or intermittently)

from June, 1947 to March, 1956
(Date) (Date)

4. Quantity of water claimed and used is 750 gallons per minute; _____ acre feet per year.

5. Purpose or Purposes for which water is used industrial

(Domestic, irrigation, municipal, manufacturing, industrial, etc.)

6. Description of Well: Depth 76 feet. Type Drilled
(Dug or drilled)

diameter 18 inches. Elevation of ground at well site 144 feet, mean sea level.
(As near as known)

Depth to water table 12 to 18 feet.

7. Capacity of Well: 750 g.p.m. with 7 ft feet drawdown.

_____ g.p.m. with _____ feet drawdown.


Date of test June, 1947

If Flowing Well: Measured discharge _____ g.p.m. on _____
(Date)

Shut-in pressure at ground surface _____ lbs. per sq. in. on _____
(Date)

Water is controlled by _____
(Cap, valve, etc.)

Township 7 S. Range 3 W., W.M.
North

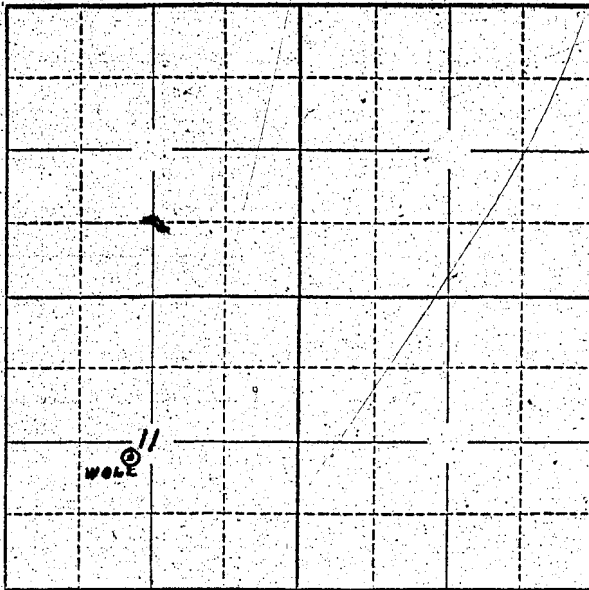

Locate well and acreage of irrigated land on plat.
Scale: 2" = 1 Mile

STATE OF OREGON

County of Marion

ss.

I, A. W. Metzger, being first duly sworn, do hereby certify that I have read the foregoing Registration Statement and that all of the items therein contained are true to the best of my knowledge and belief.

A. W. Metzger
(Signature of Registrant)

Subscribed and sworn to before me this 6th day of April March, 19 56.

My commission expires Dec. 16, 1959

Merle G. Johnson
(Notary Public)

(SEAL)

CERTIFICATE OF REGISTRATION

STATE OF OREGON

County of Marion

ss.

This is to certify that the foregoing Registration Statement was received in the office of the State Engineer on the 30th day of March, 1956, at 3:30 o'clock P. M. and has been duly recorded in said office in Book No. 7 of Registration Statements on page GR-115 C.

~~Construction shall be completed by _____ and the water completely applied to beneficial use by _____.~~

Witness my hand this 8th day of October, 19 56

Lawrence A. Stanley
(State Engineer)

By _____
(Deputy)

GR-145 C