

# Registration Statement

REGISTRATION NO. GR-1528  
CERTIFICATE NO. GR-1530

## OF CLAIMANT OF RIGHT TO APPROPRIATE GROUND WATER

(Under Chapter 708, Oregon Laws 1955.)

TO THE STATE ENGINEER OF OREGON:

I, Ralph R. Roediger  
3485 SW 24TH AVE

of Hillsboro County of Washington

State of OREGON, do hereby make application for a certificate of registration as evidence of a right to appropriate ground water.

1. Source from which water is withdrawn is Pump Well  
(Flowing well, pump well, infiltration trench, or tunnel)

2. Location is: 3 1/2 miles East Hillsboro  
(Approximate distance and direction from nearest city or town)

and is more particularly described as follows: 1050ft. S. & 700 feet west from E/corner

16 1/2 S (a) 848' South 195' West on Lot 22 with Hazel Little Farms  
(Give distance and bearing to corner of section or other legal subdivision)

being within Witch Hazel Little Farms of Sec. 9, Twp. 1 S, Rge. 2 W  
(Smallest legal subdivision) (N. or S.) (E. or W.)

or (b) within limits of recorded platted property, town or city:

in Lot \_\_\_\_\_, Block \_\_\_\_\_ of \_\_\_\_\_  
(Name of plat or addition)

County of \_\_\_\_\_  
(If within city or town, give name)

3. Construction Work was begun on MAY 1950; was completed on MAY 1950  
(Date) (Date)

and the ground water claimed was first used for the purposes set out below on JUNE 1950  
(Date)

since which time the water has been used INTERMITTENTLY FOR IRRIGATION BUT  
WATER STOCK CONTINUOUSLY  
(Continuously or intermittently)

from MAY to OCTOBER  
(Date) (Date)

4. Quantity of water claimed and used is 34 gallons per minute; \_\_\_\_\_ acre feet per year.

5. Purpose or Purposes for which water is used IRRIGATION  
(Domestic, irrigation, municipal, manufacturing, industrial, etc.)

6. Description of Well: Depth 36 feet. Type DRILLED  
(Dug or drilled)

diameter 8 inches. Elevation of ground at well site \_\_\_\_\_ feet, mean sea level.  
(As near as known)

Depth to water table 14' feet.

7. Capacity of Well: 3/4 g.p.m. with 14 feet drawdown.

\_\_\_\_\_ g.p.m. with \_\_\_\_\_ feet drawdown.

Date of test MAY 1957

If Flowing Well: Measured discharge \_\_\_\_\_ g.p.m. on \_\_\_\_\_  
(Date)

Shut-in pressure at ground surface \_\_\_\_\_ lbs. per sq. in. on \_\_\_\_\_  
(Date)


Water is controlled by \_\_\_\_\_  
(Cap, valve, etc.)







Township 15 Range 2 W, W.M.  
North

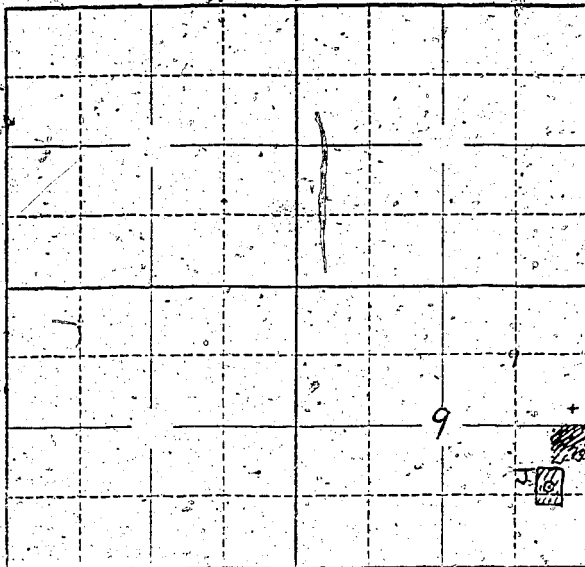

Locate well and acreage of irrigated land on plat.  
Scale: 2" = 1 Mile

STATE OF OREGON

County of Washington } ss.

I, Ralph Raediger, being first duly sworn, do hereby certify that I have read the foregoing Registration Statement and that all of the items therein contained are true to the best of my knowledge and belief.

Ralph Raediger  
(Signature of Registrant)

Subscribed and sworn to before me this 28 day of April, 1958.

My commission expires Feb. 18, 1962  
NOTARY PUBLIC FOR OREGON  
(Notary Public)

(SEAL)

**CERTIFICATE OF REGISTRATION**

STATE OF OREGON

County of Marion } ss.

This is to certify that the foregoing Registration Statement was received in the office of the State Engineer on the 29th day of April, 1958 at 5:00 o'clock P. M. and has been duly recorded in said office in Book No. 7 of Registration Statements on page GR-1530.

~~Construction shall be completed by \_\_\_\_\_ and the water completely applied or beneficial use by \_\_\_\_\_.~~

Witness my hand this 1st day of December, 1958.

[Signature]  
(State Engineer)

By \_\_\_\_\_  
(Deputy)

GR-1530

# 15.00