

Registration Statement

REGISTRATION NO. GR-153

CERTIFICATE NO. GR-146

OF CLAIMANT OF RIGHT TO APPROPRIATE GROUND WATER

(Under Chapter 708, Oregon Laws 1955.)

TO THE STATE ENGINEER OF OREGON:

I, Mellison Harper & Madge E Harper
of Junction City County of Lane
State of Oregon

do hereby make application for a certificate of registration as evidence of a right to appropriate ground water.

1. Source from which water is withdrawn is Pump well #3
(Flowing well, pump well, infiltration trench, or tunnel)

2. Location is: 1/4 mi. S.E. of Junction City, Ore.
(Approximate distance and direction from nearest city or town)

and is more particularly described as follows: well is 3094 feet N. 69° E from SW corner Wm Brice DLC #50

my SW corner is 105-15' east thence N 80 220 from
(a) the SW corner of Wm Brice DLC #50
(Give distance and bearing to corner of section or other legal subdivision)

being within the S.E. 1/4 of the N.E. 1/4 of Sec. 15, Twp. 16 S, Rge. 4 W
(Smallest legal subdivision) (N. or S.) (E. or W.)

or (b) within limits of recorded platted property, town or city: Deed entered into the S.W. 1/4 of the N.W. 1/4 of Sec 15 Twp 16 S Rge 4 W

in Lot _____, Block _____ of _____
(Name of plat or addition)

County of _____
(If within city or town, give name)

3. Construction Work was begun on Sept 1951; was completed on Sept 1951
(Date) (Date)

and the ground water claimed was first used for the purposes set out below on September 1951
(Date)

since which time the water has been used on 3 continuously on 10 1/4 intermittently
(Continuously or intermittently)

from September 1951 to Oct 1955 inclusive
(Date) (Date)

4. Quantity of water claimed and used is 100 gallons per minute; 2 acre feet per year.

5. Purpose or Purposes for which water is used Irrigation

(Domestic, irrigation, municipal, manufacturing, industrial, etc.)

6. Description of Well: Depth 28 feet. Type Driven
(Dug or drilled)

diameter 3 inches. Elevation of ground at well site 342 feet, mean sea level.
(As near as known)

Depth to water table 15 feet.

7. Capacity of Well: 145 g.p.m. with 5 feet drawdown.

 g.p.m. with feet drawdown.

Date of test Sept 1951

If Flowing Well: Measured discharge g.p.m. on
(Date)

Shut-in pressure at ground surface lbs. per sq. in. on
(Date)

Water is controlled by
(Cap, valve, etc.)

GR-146 A

size.)
3 inch diameter Galvanized Steel from entire to length feet

_____ inch diameter _____ from _____ to _____ feet

inch diameter from to feet

Describe and show depth of shoe, plug, adapter, liner or other details:

150 $\frac{1}{2}$ " holes from bottom to up 4 feet
(Number per foot and size of perforations, or describe screen)

from _____ to _____

from to

from to

[illegible]

If log of well is not available, give name and address of driller. _____

11. Infiltration Trench: Covered or open

Dimensions: Length ft. Minimum depth ft. Maximum depth ft.

Bottom width ft. Discharge g.p.m. Date of test

12. Tunnel: Type of lining-----

Dimensions: _____
(Length, course, and cross sectional size)

Position of water bearing stratum with reference to portal of tunnel

Log of tunnel: (Preceding table for log of well may be used, if desired. Give footage from portal and character of materials, as pertinent.)

13. Pumping Equipment:

Motor and Pump Comb-3HP 13.5 ft Head Electric Capacity 90 g.p.m.
(Make, type and size)

(b) Motor _____
(Type and horsepower)


14. Location of area irrigated or to be irrigated, or place of use if for purposes other than irrigation.

[illegible]

15- If the ground water supply is supplemental to an existing water supply, identification of any application for a permit, permit, certificate or adjudicated right to appropriate water made or held by the registrant.

GR-146 C

Township 16 S. Range 4 W. W.M.
Sec. 9 North Sec. 10

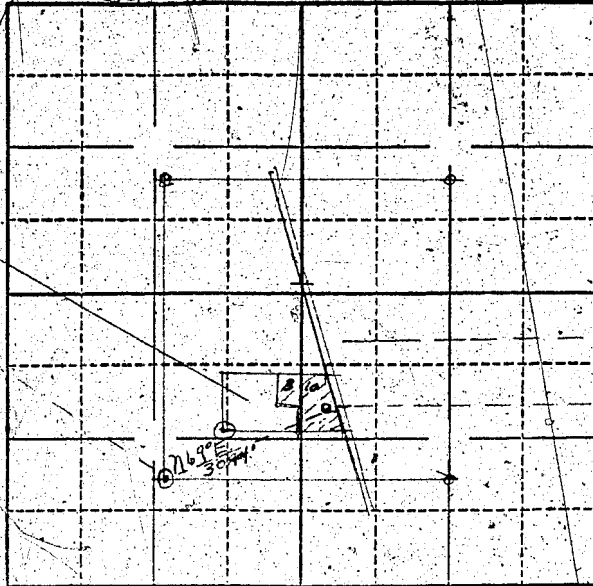

Locate well and acreage of irrigated land on plat.
Scale: 2" = 1 Mile

STATE OF OREGON

County of Lane } ss.

I, Phillip E. Harper & Midge E. Harper, being first duly sworn, do hereby certify that I have read the foregoing Registration Statement and that all of the items therein contained are true to the best of my knowledge and belief.

Subscribed and sworn to before me this 28th day of March, 1956

My commission expires April 11, 1956 Phillip E. Harper
(Notary Public)

(SEAL)

See Page GR-146 H for
CERTIFICATE OF REGISTRATION

STATE OF OREGON

County of Marion } ss.




(Deputy)

GR-146 D

Registration Statement

REGISTRATION NO. GR-153

CERTIFICATE NO. GR-146

OF CLAIMANT OF RIGHT TO APPROPRIATE GROUND WATER

(Under Chapter 708, Oregon Laws 1955.)

TO THE STATE ENGINEER OF OREGON:

I, William Harper Modg Hub 3650 River Road
of Junction City County of Lane
State of Oregon, do hereby make application for a certificate of registration as evidence
of a right to appropriate ground water.

1. Source from which water is withdrawn is Pump Well #4
(Flowing well, pump well, infiltration trench, or tunnel)

2. Location is: 4 Miles S E Junction City Ore
(Approximate distance and direction from nearest city or town)

and is more particularly described as follows:

(a) My S W Corner is 105-1.8 east thence 802.20' N
from S W Corner Wm Bruce Dutton Land Claim No 57
(Give distance and bearing to corner of section or other legal subdivision)

being within the S E 1/4 of NE 1/4 of Sec. 16, Twp. 16 S, Rge. 4 W
(Smallest legal subdivision) (N. or S.) (E. or W.)

or (b) within limits of recorded platted property, town or city:

in Lot _____, Block _____ of _____
(Name of plat or addition)

County of _____
(If within city or town, give name)

3. Construction Work was begun on May 1954; was completed on May 1954
(Date) (Date)

and the ground water claimed was first used for the purposes set out below on May 1954
(Date)

since which time the water has been used Continuously
(Continuously or intermittently)

from May 1954 to 1955 inclusive
(Date) (Date)

4. Quantity of water claimed and used is 175 gallons per minute; 1 acre
feet per year. in 1954 and 1955

5. Purpose or Purposes for which water is used Irrigation
(Domestic, irrigation, municipal, manufacturing, industrial, etc.)

6. Description of Well: Depth 28 feet. Type Driven
(Dug or drilled)

diameter 3 inches. Elevation of ground at well site 342 feet, mean sea level.
(As near as known)

Depth to water table 12 feet.

7. Capacity of Well: 175 g.p.m. with 5 feet drawdown.

_____ g.p.m. with _____ feet drawdown.

Date of test May 1954

If Flowing Well: Measured discharge _____ g.p.m. on _____ (Date)

Shut-in pressure at ground surface _____ lbs. per sq. in. on _____ (Date)

Water is controlled by _____
(Cap, valve, etc.)

GR-146 E

3	inch diameter	Galvanized steel	from top	to Bottom	feet 2.8
	inch diameter		from	to	feet
	inch diameter		from	to	feet
	inch diameter		from	to	feet

150 Round Holes $\frac{1}{2}$ " from Bottom to top 4 feet
(Number per foot and size of perforations, or describe screen)

from _____ to _____

from _____ to _____

from _____ to _____

from _____ to _____

[illegible]

If log of well is not available, give name and address of driller. —

11. Infiltration Trench: Covered or open

Dimensions: Length ft. Minimum depth ft. Maximum depth ft.

Bottom width - ft. Discharge g.p.m. Date of test

12. Tunnel: Type of lining

Dimensions: _____
(Length, course, and cross sectional size)

Position of water bearing stratum with reference to portal of tunnel

Log of tunnel: (Preceding table for log of well may be used, if desired. Give footage from portal and character of materials, as pertinent.)

13. Pumping Equipment:

(a) Pump *Fantaupe Morse 2 1/2" intake 1/2" outlet 120 ft head* Capacity *200* g.p.m.

(b) Motor Pump mounted on my Model-A Mc Cormick tractor


14. Location of area irrigated or to be irrigated, or place of use if for purposes other than irrigation.

[illegible]

15. If the ground water supply is supplemental to an existing water supply, identification of any application for a permit, permit, certificate or adjudicated right to appropriate water made or held by the registrant.

GR-146G

Township 16 S Range 4 W, W.M.
Sec 9 North Sec 10

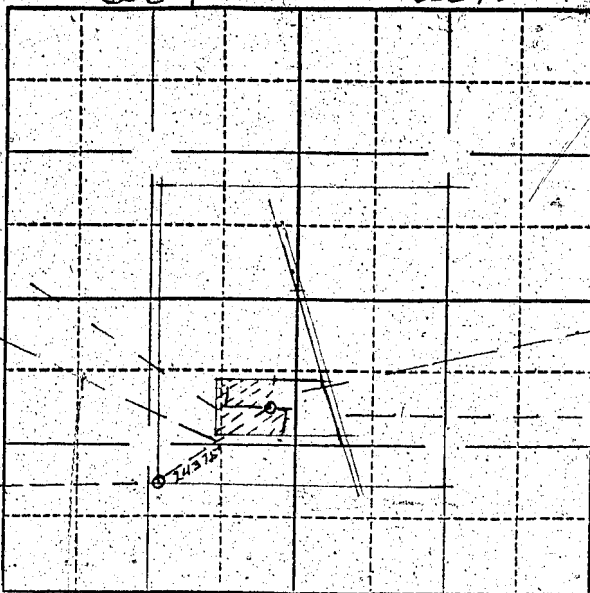

Pipe Line

Well is $75^{\circ}30'E$
2437.5 from SW
Cor Wm Buell D.L.C.

404 ac. tract to
be irrigated

River Road

SW cor Wm Buell
D.L.C. #50 marked
by Stone Top above ground

Locate well and acreage of irrigated land on plat.

Scale: 2" = 1 Mile

STATE OF OREGON

County of Lane

ss.

I, William Harper & Madge E. Harper, being first duly sworn, do hereby certify that I have read the foregoing Registration Statement and that all of the items therein contained are true to the best of my knowledge and belief.

Subscribed and sworn to before me this 28th day of March, 1956

My commission expires April 11, 1956

(Notary Public)

(SEAL)

CERTIFICATE OF REGISTRATION

STATE OF OREGON

County of Marion

ss.

This is to certify that the foregoing Registration Statement was received in the office of the State Engineer on the 30th day of March, 1956, at 3:30 o'clock P.M. and has been duly recorded in said office in Book No. 1 of Registration Statements on page GR-116 H

~~Construction not completed by 1956 and the water completely applied to beneficial use by 1956~~

Witness my hand this 8th day of October, 1956

Lewis A. Stanley
(State Engineer)

By

(Deputy)

GR-146 H