

RECEIVED
MAY 1 1958

STATE ENGINEER
SALEM, OREGON

Registration No. GR - 1535

Certificate No. GR - 1478

Registration Statement

OF CLAIMANT OF RIGHT TO APPROPRIATE GROUND WATER

TO THE STATE ENGINEER OF OREGON:

I, J. A. Fobert, Juanita Fobert
of RTI Box 87 Woodburn County of Marion
(Mailing address)

State of Oregon, do hereby make application for a certificate of registration as evidence of a right to appropriate ground water.

1. Source from which water is withdrawn is Pump Well #1
(Flowing well, pump well, infiltration trench, or tunnel)

2. Location is: 1 Mile North of Woodburn on U.S. 99
(Approximate distance and direction from nearest city or town)

and is more particularly described as follows:

(a) 400 feet south & 750 feet west from NE corner of Section 8
(Give distance and bearing to corner of section or other legal subdivision)

being within NE 1/4 of N.E. 1/4 of Sec. 8 Twp. 5 S. Rge. 1 W.
(Smallest legal subdivision) (N. or S.) (E. or W.)

or (b) within limits of recorded platted property, town or city:

in Lot _____ Block _____ of _____
(Name of plat or addition)
County of Marion
(If within city or town, give name)

3. Construction Work was begun on Jan. 2, 1951 was completed on Jan. 16, 1951
(Date) (Date)

and the ground water claimed was first used for the purposes set out below on May 19 51
(Date)

since which time the water has been used Intermittently
(Continuously or intermittently)

from May to September
(Date) (Date)

4. Quantity of water claimed and used is 320 gallons per minute; _____ acre feet per year.

5. Purpose or Purposes for which water is used Irrigation
(Domestic, irrigation, municipal, manufacturing, industrial, etc.)

6. Description of Well: Depth 127 feet. Type Drilled (Cable Tools)
(Dug or drilled)

diameter 8 inches. Elevation of ground at well site 178 feet, mean sea level.
(As near as known)

Depth to water table 30 feet.

7. Capacity of Well: 250 g.p.m. with 17 feet drawdown.

_____ g.p.m. with _____ feet drawdown.


Date of test Jan. 15, 1951

If Flowing Well: Measured discharge _____ g.p.m. on _____
(Date)

Shut-in pressure at ground surface _____ lbs. per sq. in. on _____
(Date)

Water is controlled by _____
(Cap. valve, etc.)

Township 55 Range 1W W.M.
North

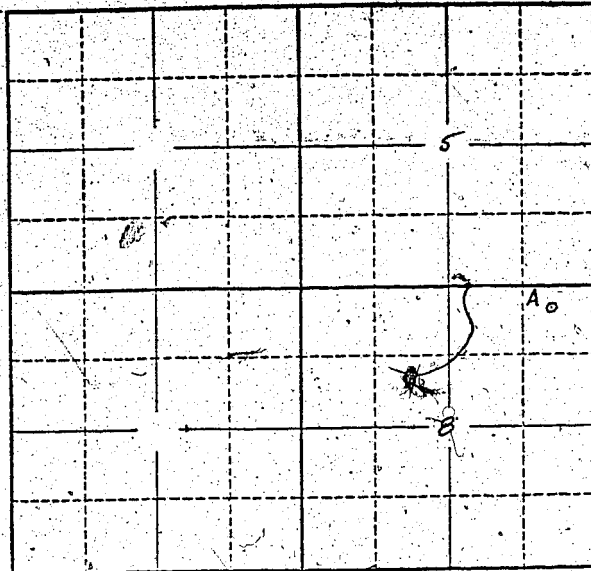

Locate well and acreage of irrigated land on plat.
Scale: 2" = 1 Mile

STATE OF OREGON

County of Marion

} ss.

I, _____, being first duly sworn, do hereby certify that I have read the foregoing Registration Statement and that all of the items therein contained are true to the best of my knowledge and belief.

Jessita Fabert
(Signature of Registrant)

Subscribed and sworn to before me this 28th day of April, 1958

My commission expires 12th June 1961

Wm. S. Bartholomew
(Notary Public)

(SEAL)

CERTIFICATE OF REGISTRATION

STATE OF OREGON

County of Marion

} ss.

This is to certify that the foregoing Registration Statement was received in the office of the State Engineer on the 1st day of May, 1958, at 8:00 o'clock A. M. and has been duly recorded in said office in Book No. 7 of Registration Statements on page GR-1478

Witness my hand this 1st day of December, 1958

Henry A. Stanley
(State Engineer)

By _____

(Deputy)

GR - 1478

\$16.50