

RECEIVED  
MAY 2 1958  
STATE ENGINEER  
SALEM, OREGON

REGISTRATION NO. GR-1538  
CERTIFICATE NO. GR-1481

### Registration Statement

OF CLAIMANT OF RIGHT TO APPROPRIATE GROUND WATER

(Under Chapter 703, Oregon Laws 1955.)

TO THE STATE ENGINEER OF OREGON:

I, E. J. Lindquist & R. E. Lindquist  
of P.O. Box 832 Beaverton County of WASHINGTON  
State of OREGON, do hereby make application for a certificate of registration as evidence  
of a right to appropriate ground water.

1. Source from which water is withdrawn is Pump Well  
(Flowing well, pump well, infiltration trench, or tunnel)

2. Location is: 1/4 MI. EAST of Kinton on Highway 210  
(Approximate distance and direction from nearest city or town)

and is more particularly described as follows:

(a) N38°27'E 347' from SW Corner SEC. 6  
(Give distance and bearing to corner of section or other legal subdivision)  
being within SW 1/4 of NW 1/4 of Sec. 6, Twp. 25, Rge. 1 W  
(Smallest legal subdivision) (or or S.) (E. or W.)

or (b) within limits of recorded platted property, town or city:

in Lot \_\_\_\_\_, Block \_\_\_\_\_ of \_\_\_\_\_  
(Name of plat or addition)  
County of WASHINGTON  
(If within city or town, give name)

3. Construction Work was begun on Oct 15 1957; was completed on \_\_\_\_\_  
(Date) (Date)

and the ground water claimed was first used for the purposes set out below on Nov 1 1957  
(Date)

since which time the water has been used CONTINUOUSLY  
(Continuously or intermittently)

from Nov 1 1957 to continuous  
(Date) (Date)

4. Quantity of water claimed and used is 13.5 gallons per minute; 7 acre  
feet per year.

5. Purpose or Purposes for which water is used Irrigation  
(Domestic, irrigation, municipal, manufacturing, industrial, etc.)

6. Description of Well: Depth 514 feet. Type drilled  
(Dug or drilled)  
diameter \_\_\_\_\_ inches. Elevation of ground at well site \_\_\_\_\_ feet, mean sea level.  
(As near as known)  
Depth to water table \_\_\_\_\_ feet.

7. Capacity of Well: \_\_\_\_\_ g.p.m. with \_\_\_\_\_ feet drawdown.  
\_\_\_\_\_ g.p.m. with \_\_\_\_\_ feet drawdown.

Date of test \_\_\_\_\_

If Flowing Well: Measured discharge \_\_\_\_\_ g.p.m. on \_\_\_\_\_  
(Date)

Shut-in pressure at ground surface \_\_\_\_\_ lbs. per sq. in. on \_\_\_\_\_  
(Date)

Water is controlled by \_\_\_\_\_  
(Cap, valve, etc.)

8. Casing: (Give diameter, commercial specifications and depth below ground surface of each casing size.)

8 inch diameter Steel Well Casing from 0 to 29 feet  
8 inch diameter Solid Rock - No CASINGS from 29 to 544 feet  
inch diameter from to feet  
inch diameter from to feet

Describe and show depth of shoe, plug, adapter, liner or other details: NONE

9. Perforated Casings or Screens:

NONE from to  
(Number per foot and size of perforations, or describe screen)  
from to  
from to  
from to

10. Log of Well: (Describe each stratum or formation clearly, indicate if water bearing, and give thickness and depth as indicated.)

MATERIAL	Thickness (Feet)	Depth to Bottom (Feet)

If log of well is not available, give name and address of driller. *Bill Sennett*

*Oregon City Oregon*

11. Infiltration Trench: Covered or open *NONE*  
 Dimensions: Length \_\_\_\_\_ ft. Minimum depth \_\_\_\_\_ ft. Maximum depth \_\_\_\_\_ ft.  
 Bottom width \_\_\_\_\_ ft. Discharge \_\_\_\_\_ g.p.m. Date of test \_\_\_\_\_

12. Tunnel: Type of lining *NONE*  
 Dimensions: \_\_\_\_\_  
(Length, course, and cross sectional size)  
 Position of water bearing stratum with reference to portal of tunnel \_\_\_\_\_

Log of tunnel: (Preceding table for log of well may be used, if desired. Give footage from portal and character of materials, as pertinent.)


13. Pumping Equipment:  
 (a) Pump *JOHNSON TURBINE 4"* Capacity *135* g.p.m.  
(Make, type and size)  
 (b) Motor *10 H.P. ELECTRIC*  
(Type and horsepower)

14. Location of area irrigated or to be irrigated, or place of use if for purposes other than irrigation.

Township North or South	Range E. or W. of Willamette Meridian	Section	Forty-acre Tract	Number Acres To Be Irrigated	Date of Reclamation
<i>T 25</i>	<i>R 1 W</i>	<i>6</i>	<i>SW 1/4 of NW 1/4</i>	<i>7</i>	<i>May 1957 (TOTAL)</i>

15. If the ground water supply is supplemental to an existing water supply, identification of any application for a permit, permit, certificate or adjudicated right to appropriate water made or held by the registrant.

Township 25 Range 1W, W.M.  
North

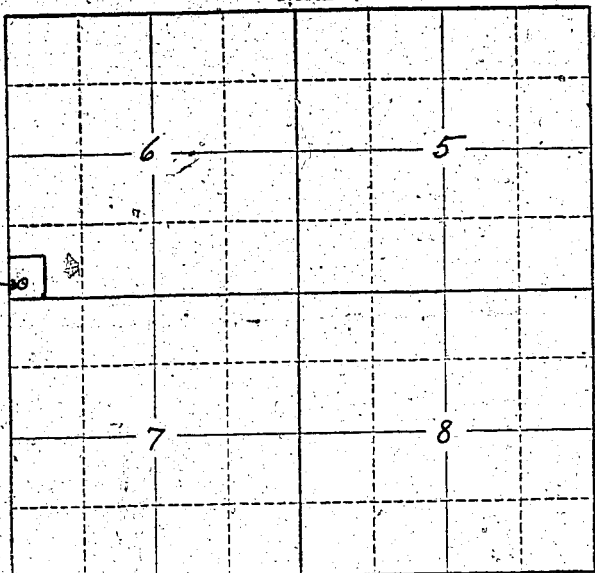

Locate well and acreage of irrigated land on plat.  
Scale: 2" = 1 Mile

STATE OF OREGON

County of .....

} ss.

I, \_\_\_\_\_, being first duly sworn, do hereby certify that I have read the foregoing Registration Statement and that all of the items therein contained are true to the best of my knowledge and belief.

*[Signature]*  
\_\_\_\_\_  
(Signature of Registrant)

Subscribed and sworn to before me this 30 day of April, 1958

My commission expires 12-20-58

*[Signature]*  
\_\_\_\_\_  
(Notary Public)

My Commission Expires Dec. 20, 1958

(SEAL)

**CERTIFICATE OF REGISTRATION**

STATE OF OREGON

County of Marion

} ss.

This is to certify that the foregoing Registration Statement was received in the office of the State Engineer on the 2nd day of May, 1958, at 6:00 o'clock A.M. and has been duly recorded in said office in Book No. 7 of Registration Statements on page GR-1481

~~Construction shall be completed by \_\_\_\_\_ and the water completely applied to beneficial use by \_\_\_\_\_~~

Witness my hand this 1st day of December, 1958

*[Signature]*  
\_\_\_\_\_  
(State Engineer)

By \_\_\_\_\_  
(Deputy)

**GR-1481**

#1500