

**RECEIVED**  
MAY 2 1958  
STATE ENGINEER  
SALEM OREGON

Registration No. GR - 1540

Certificate No. GR - 1483

# Registration Statement

## OF CLAIMANT OF RIGHT TO APPROPRIATE GROUND WATER

TO THE STATE ENGINEER OF OREGON:

I, Harvey Ewert

of Rt. 1 Box 144 Dayton Oregon County of Yamhill  
(Mailing address)

State of Oregon, do hereby make application for a certificate of registration as evidence of a right to appropriate ground water.

1. Source from which water is withdrawn is Pump Well #3  
(Flowing well, pump well, infiltration trench, or tunnel)

2. Location is: 9 Miles North West of Dayton Oregon  
(Approximate distance and direction from nearest city or town)

and is more particularly described as follows:

(a) 650' W and 800' N from S E corner Section 23 in S E 1/4 S E 1/4  
(Give distance and bearing to corner of section or other legal subdivision)

being within SE 1/4 of SE 1/4 of Sec. 23, Twp. 5S, Rge. 3W  
(Smallest legal subdivision) (N. or S.) (E. or W.)

or (b) within limits of recorded platted property, town or city:

in Lot \_\_\_\_\_, Block \_\_\_\_\_ of \_\_\_\_\_  
(Name of plat or addition)

County of \_\_\_\_\_  
(If within city or town, give name)

3. Construction Work was begun on unknown; was completed on 1928  
(Date) (Date)

and the ground water claimed was first used for the purposes set out below on 1928  
(Date)

since which time the water has been used Intermittently  
(Continuously or Intermittently)

from 1928 to 1958  
(Date) (Date)

4. Quantity of water claimed and used is 250 gallons per minute; 40 acre feet per year.

5. Purpose or Purposes for which water is used Irrigation

(Domestic, irrigation, municipal, manufacturing, industrial, etc.)

6. Description of Well: Depth 25 feet. Type Drilled  
(Dug or drilled)

diameter 10 inches. Elevation of ground at well site 100 feet, mean sea level.  
(As near as known)

Depth to water table 10 feet.

7. Capacity of Well: \_\_\_\_\_ g.p.m. with \_\_\_\_\_ feet drawdown.

\_\_\_\_\_ g.p.m. with \_\_\_\_\_ feet drawdown.

Date of test \_\_\_\_\_

If Flowing Well: Measured discharge \_\_\_\_\_ g.p.m. on \_\_\_\_\_  
(Date)


Shut-in pressure at ground surface \_\_\_\_\_ lbs. per sq. in. on \_\_\_\_\_  
(Date)

Water is controlled by \_\_\_\_\_  
(Cap, valve, etc.)





Township 5 S Range 3 W W.M.  
North

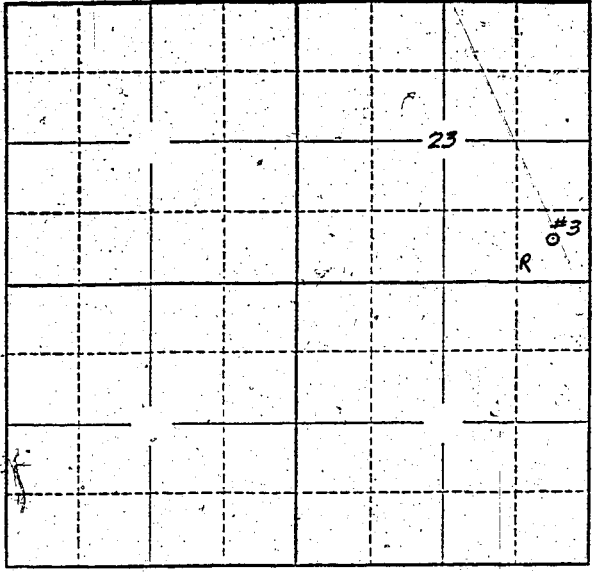

Refer to Map on  
no 2

Locate well and acreage of irrigated land on plat.  
Scale: 2" = 1 Mile

STATE OF OREGON

County of YAMHILL ss.

I, Harvey Ewert, being first duly sworn, do hereby certify that I have read the foregoing Registration Statement and that all of the items therein contained are true to the best of my knowledge and belief.

*Harvey Ewert*  
(Signature of Registrant)

Subscribed and sworn to before me this 8th day of April, 19 58

My commission expires           
*Archie M. Gungus*  
(Notary Public)

(SEAL)

**CERTIFICATE OF REGISTRATION**

STATE OF OREGON }  
County of Marion } ss.

This is to certify that the foregoing Registration Statement was received in the office of the State Engineer on the 2nd day of May, 1958, at 8:00 o'clock A.M. and has been duly recorded in said office in Book No. 7 of Registration Statements on page GR-1483

Witness my hand this 1st day of December, 19 58

*Laura A. Stanley*  
(State Engineer)

By           
(Deputy)