

RECEIVED
MAY 2 1958
STATE ENGINEER
SALEM, OREGON

Registration No. GR - 1541
Certificate No. GR - 1484

Registration Statement

OF CLAIMANT OF RIGHT TO APPROPRIATE GROUND WATER

TO THE STATE ENGINEER OF OREGON:

I, Harvey Ewert

of Rt. 1 Box 144 Dayton Oregon County of Yamhill
(Mailing address)

State of Oregon, do hereby make application for a certificate of registration as evidence of a right to appropriate ground water.

1. Source from which water is withdrawn is Pump Well #2
(Flowing well, pump well, infiltration trench, or tunnel)
2. Location is: 9 Miles North West of Dayton Oregon
(Approximate distance and direction from nearest city or town)

and is more particularly described as follows:

(a) 650' W and 1750' N from S E corner Section 23 in NE 1/4 S E 1/4
(Give distance and bearing to corner of section or other legal subdivision) Sec 23 T5S R3W
being within NE 1/4 of SE 1/4 of Sec. 23, Twp. 5S, Rge. 3W
(Smallest legal subdivision) (N. or S.) (E. or W.)

or (b) within limits of recorded platted property, town or city:

in Lot _____, Block _____ of _____
(Name of plat or addition)
County of _____
(If within city or town, give name)

3. Construction Work was begun on unk; was completed on 1928
(Date) (Date)

and the ground water claimed was first used for the purposes set out below on 1928
(Date)

since which time the water has been used Continuously
(Continuously or intermittently)

from 1928 to 1958
(Date) (Date)

4. Quantity of water claimed and used is 280 gallons per minute; 50 acre feet per year.

5. Purpose or Purposes for which water is used Domestic irrigation

(Domestic, irrigation, municipal, manufacturing, industrial, etc.)

6. Description of Well: Depth 25 feet. Type Drilled
(Dug or drilled)

diameter 10 inches. Elevation of ground at well site _____ feet, mean sea level.
(As near as known)

Depth to water table 5 feet.

7. Capacity of Well: 150 g.p.m. with 15 feet drawdown.

_____ g.p.m. with _____ feet drawdown.

Date of test May 1956

If Flowing Well: Measured discharge _____ g.p.m. on _____
(Date)

Shut-in pressure at ground surface _____ lbs. per sq. in. on _____
(Date)

Water is controlled by _____
(Cap, valve, etc.)

8. Casing: (Give diameter, commercial specifications and depth below ground surface of each casing size.)

10 inch diameter from Top to 25' feet
inch diameter from to feet
inch diameter from to feet
inch diameter from to feet

Describe and show depth of shoe, plug, adapter, liner or other details:

9. Perforated Casings or Screens:

unk from to
(Number per foot and size of perforations, or describe screen)
from to
from to
from to

10. Log of Well: (Describe each stratum or formation clearly, indicate if water bearing, and give thickness and depth as indicated.)

MATERIAL	Thickness (Feet)	Depth to Bottom (Feet)
<i>unk</i>		

If log of well is not available, give name and address of driller. _____

11. **Infiltration Trench:** Covered or open _____

Dimensions: Length _____ ft. Minimum depth _____ ft. Maximum depth _____ ft.

Bottom width _____ ft. Discharge _____ g.p.m. Date of test _____

12. **Tunnel:** Type of lining _____

Dimensions: _____
(Length, course, and cross sectional size)

Position of water bearing stratum with reference to portal of tunnel _____

Log of tunnel: (Preceding table for log of well may be used, if desired. Give footage from portal and character of materials, as pertinent.)

13. **Pumping Equipment:**

(a) Pump 2X2 I/2 Capacity 200 g.p.m.
(Make, type and size)


(b) Motor 10 H.P.
(Type and horsepower)

14. **Location of area irrigated or to be irrigated, or place of use if for purposes other than irrigation.**

Township North or South	Range E. or W. of Willamette Meridian	Section	Forty-acre Tract	Number Acres To Be Irrigated	Date of Reclamation
5S	3W	23	NE $\frac{1}{4}$ SE $\frac{1}{4}$	16 ac	1920
"	"	"	SE $\frac{1}{4}$ SE $\frac{1}{4}$	10 ac	"
				<u>26</u> ac	

15. **If the ground water supply is supplemental to an existing water supply, identification of any application for a permit, permit, certificate or adjudicated right to appropriate water made or held by the registrant.**

Township 55 Range 3W W.M.
North

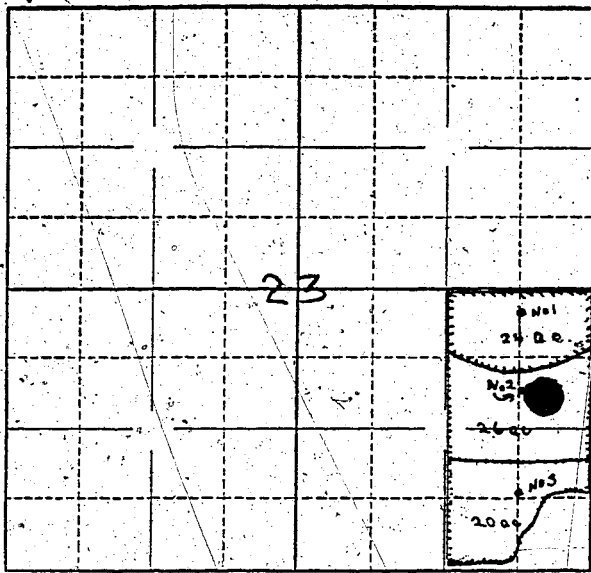

Locate well and acreage of irrigated land on plat.
Scale: ~~1/4~~ 1/2 - 1 Mile

STATE OF OREGON

County of Yamhill } ss.

I, Harvey Ewert, being first duly sworn, do hereby certify that I have read the foregoing Registration Statement and that all of the items therein contained are true to the best of my knowledge and belief.

Harvey Ewert
(Signature of Registrant)

Subscribed and sworn to before me this 8th day of April, 19 58

My commission expires Annex M Gaviger
(Notary Public)

(SEAL)

CERTIFICATE OF REGISTRATION

STATE OF OREGON

County of Marion } ss.

This is to certify that the foregoing Registration Statement was received in the office of the State Engineer on the 2nd day of May, 19 58, at 8:00 o'clock A. M. and has been duly recorded in said office in Book No. 7 of Registration Statements on page 6E-1484

Witness my hand this 1st day of December, 19 58

Lewis A. Stanley
(State Engineer)

By _____
(Deputy)

\$1500